
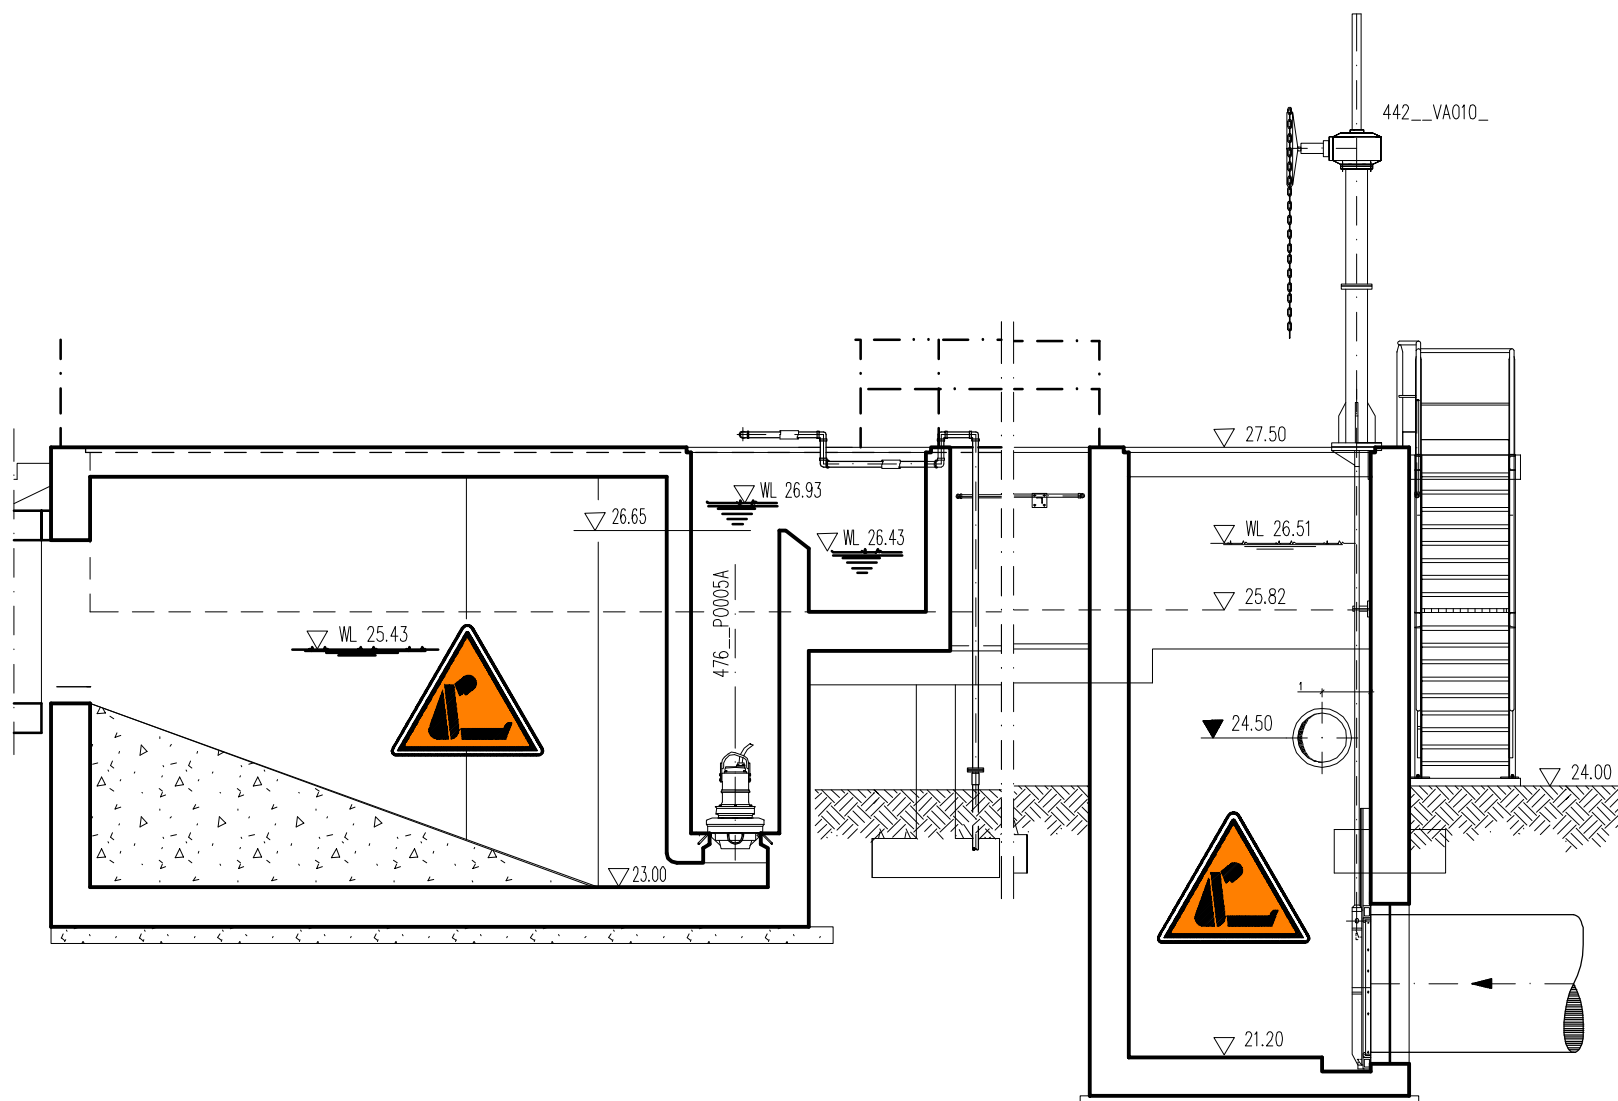


TITOLO				
ZONAGE – Allegato 01				
PROJECT CODE E612001I PROJECT NAME Impianto di depurazione Santa Giustina di Rimini	FILE		PAGE 1	NEXT 1
	DRAWN BY ESC/RRI	CONTROLLED BY PPI	APPROVED BY. ESC	
	DRAWING G – DGT – SZ – 400 – 005 – 00-A			

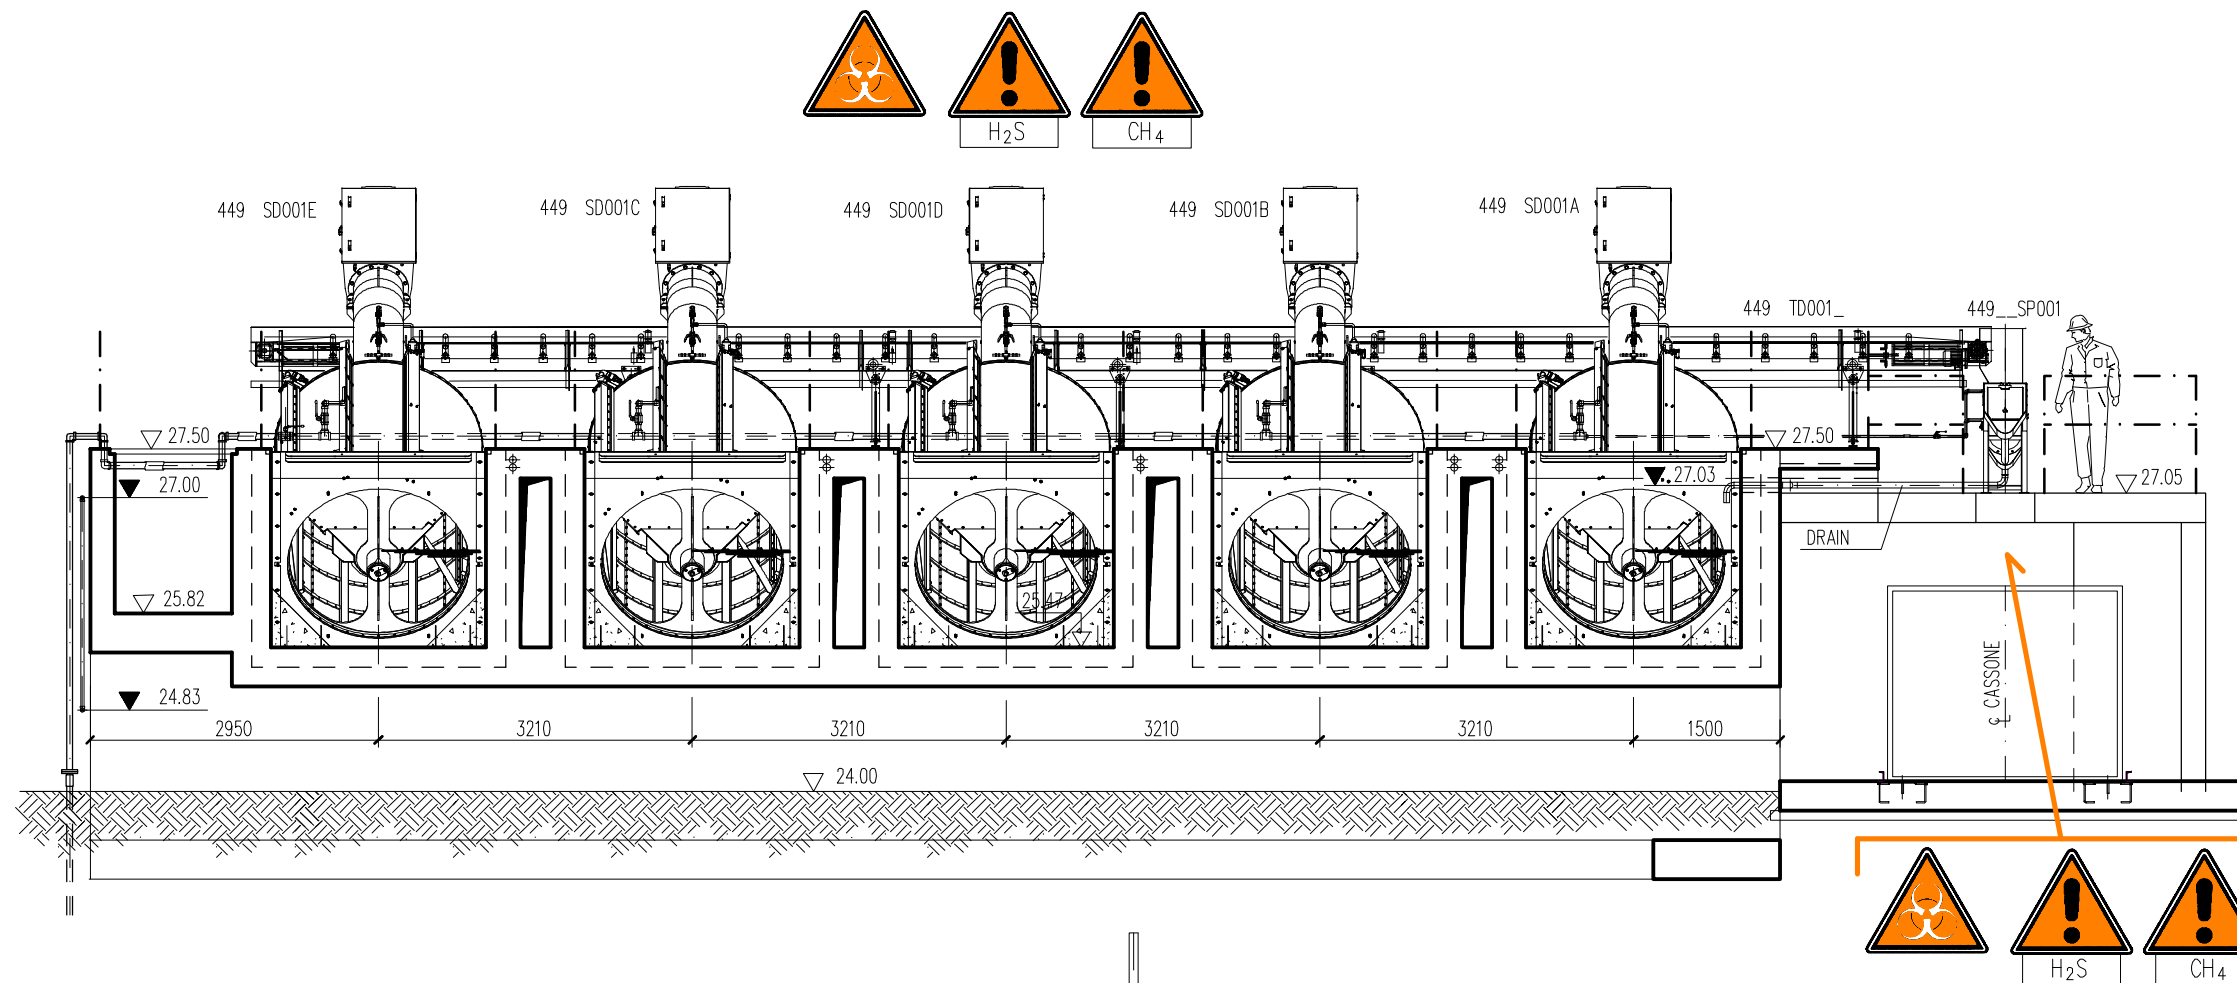

AS-BUILT

TITOLO

ZONAGE - Allegato 02

PROJECT CODE E612001I

PROJECT NAME

Impianto di depurazione Santa Giustina di Rimini

FILE

PAGE 1

NEXT 1


DRAWN BY
ESC/RRI

CONTROLLED BY
PPI

APPROVED BY
ESC

DRAWING

G - DGT - SZ - 449 - 005 - 00-A

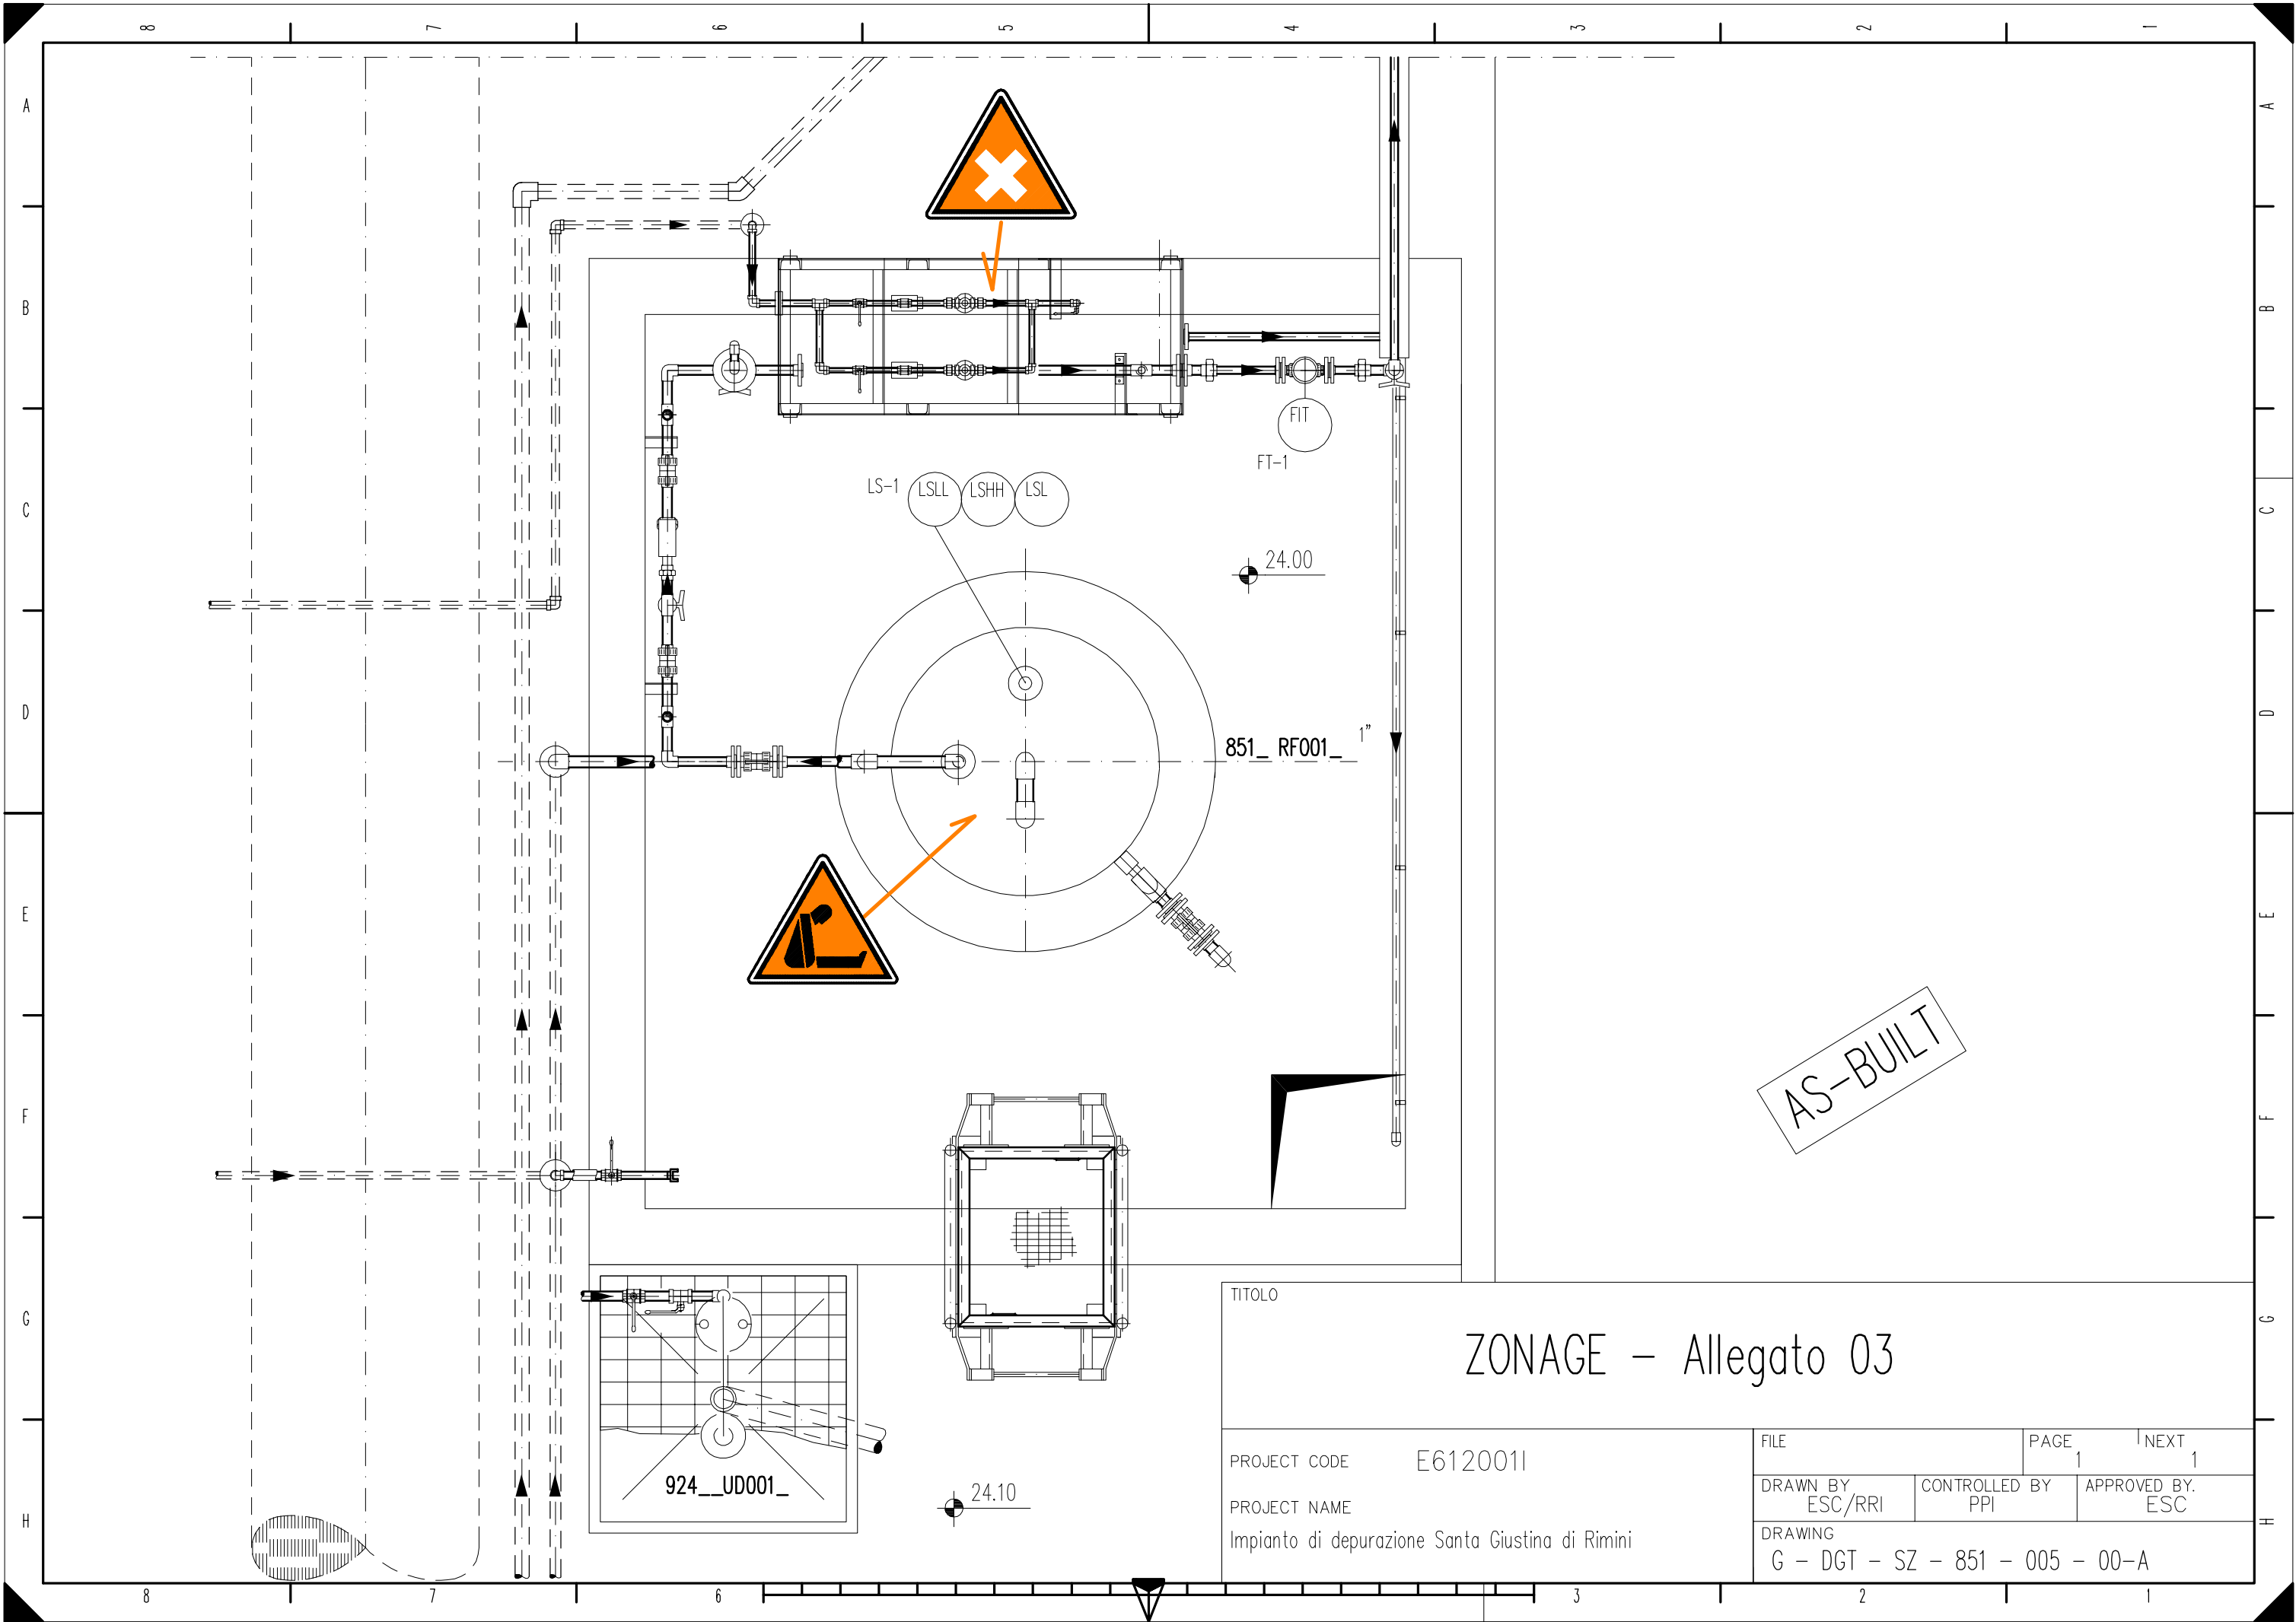

AS-BUILT


TITOLO

ZONAGE - Allegato 03

PROJECT CODE E612001I

PROJECT NAME
Impianto di depurazione Santa Giustina di Rimini

FILE	PAGE 1	NEXT 1
DRAWN BY ESC/RRI	CONTROLLED BY PPI	APPROVED BY. ESC
DRAWING G - DGT - SZ - 851 - 005 - 00-A		

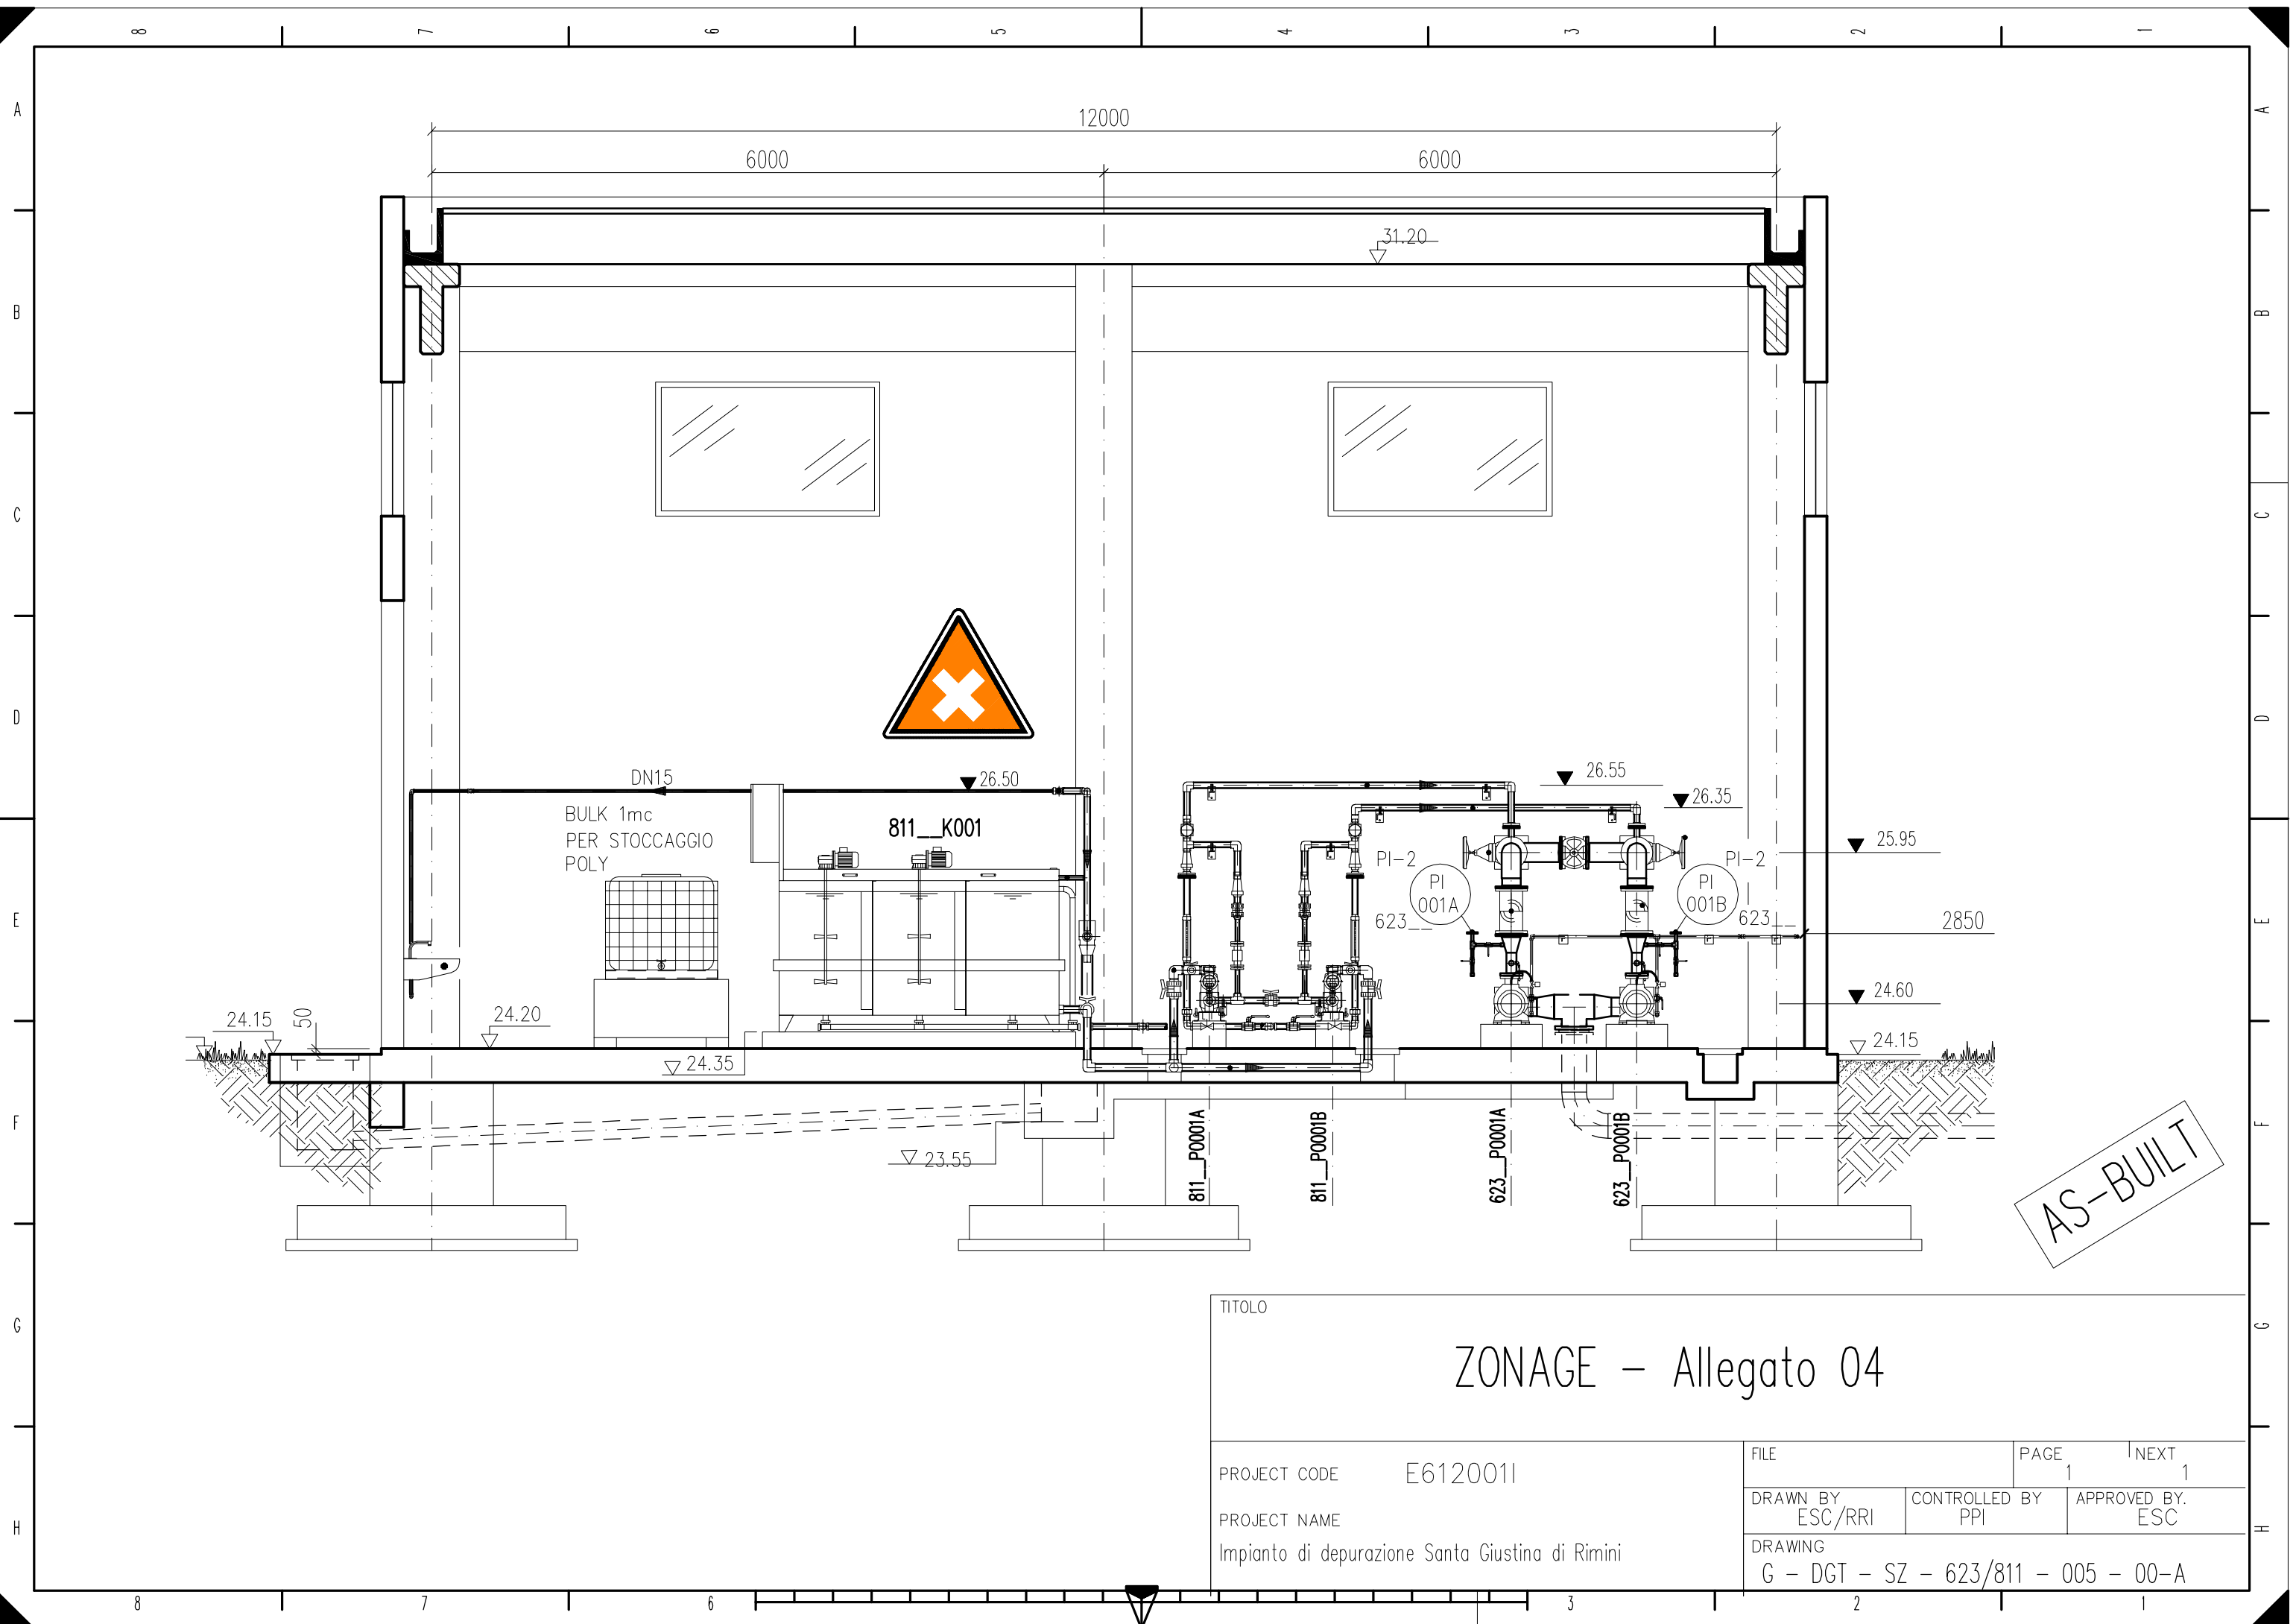

TITOLO

ZONAGE - Allegato 04

PROJECT CODE E612001I

PROJECT NAME

Impianto di depurazione Santa Giustina di Rimini

FILE

PAGE

NEXT


DRAWN BY
ESC/RR1


CONTROLLED BY
PPI


APPROVED BY.
ESC

DRAWING

G - DGT - SZ - 623/811 - 005 - 00-A

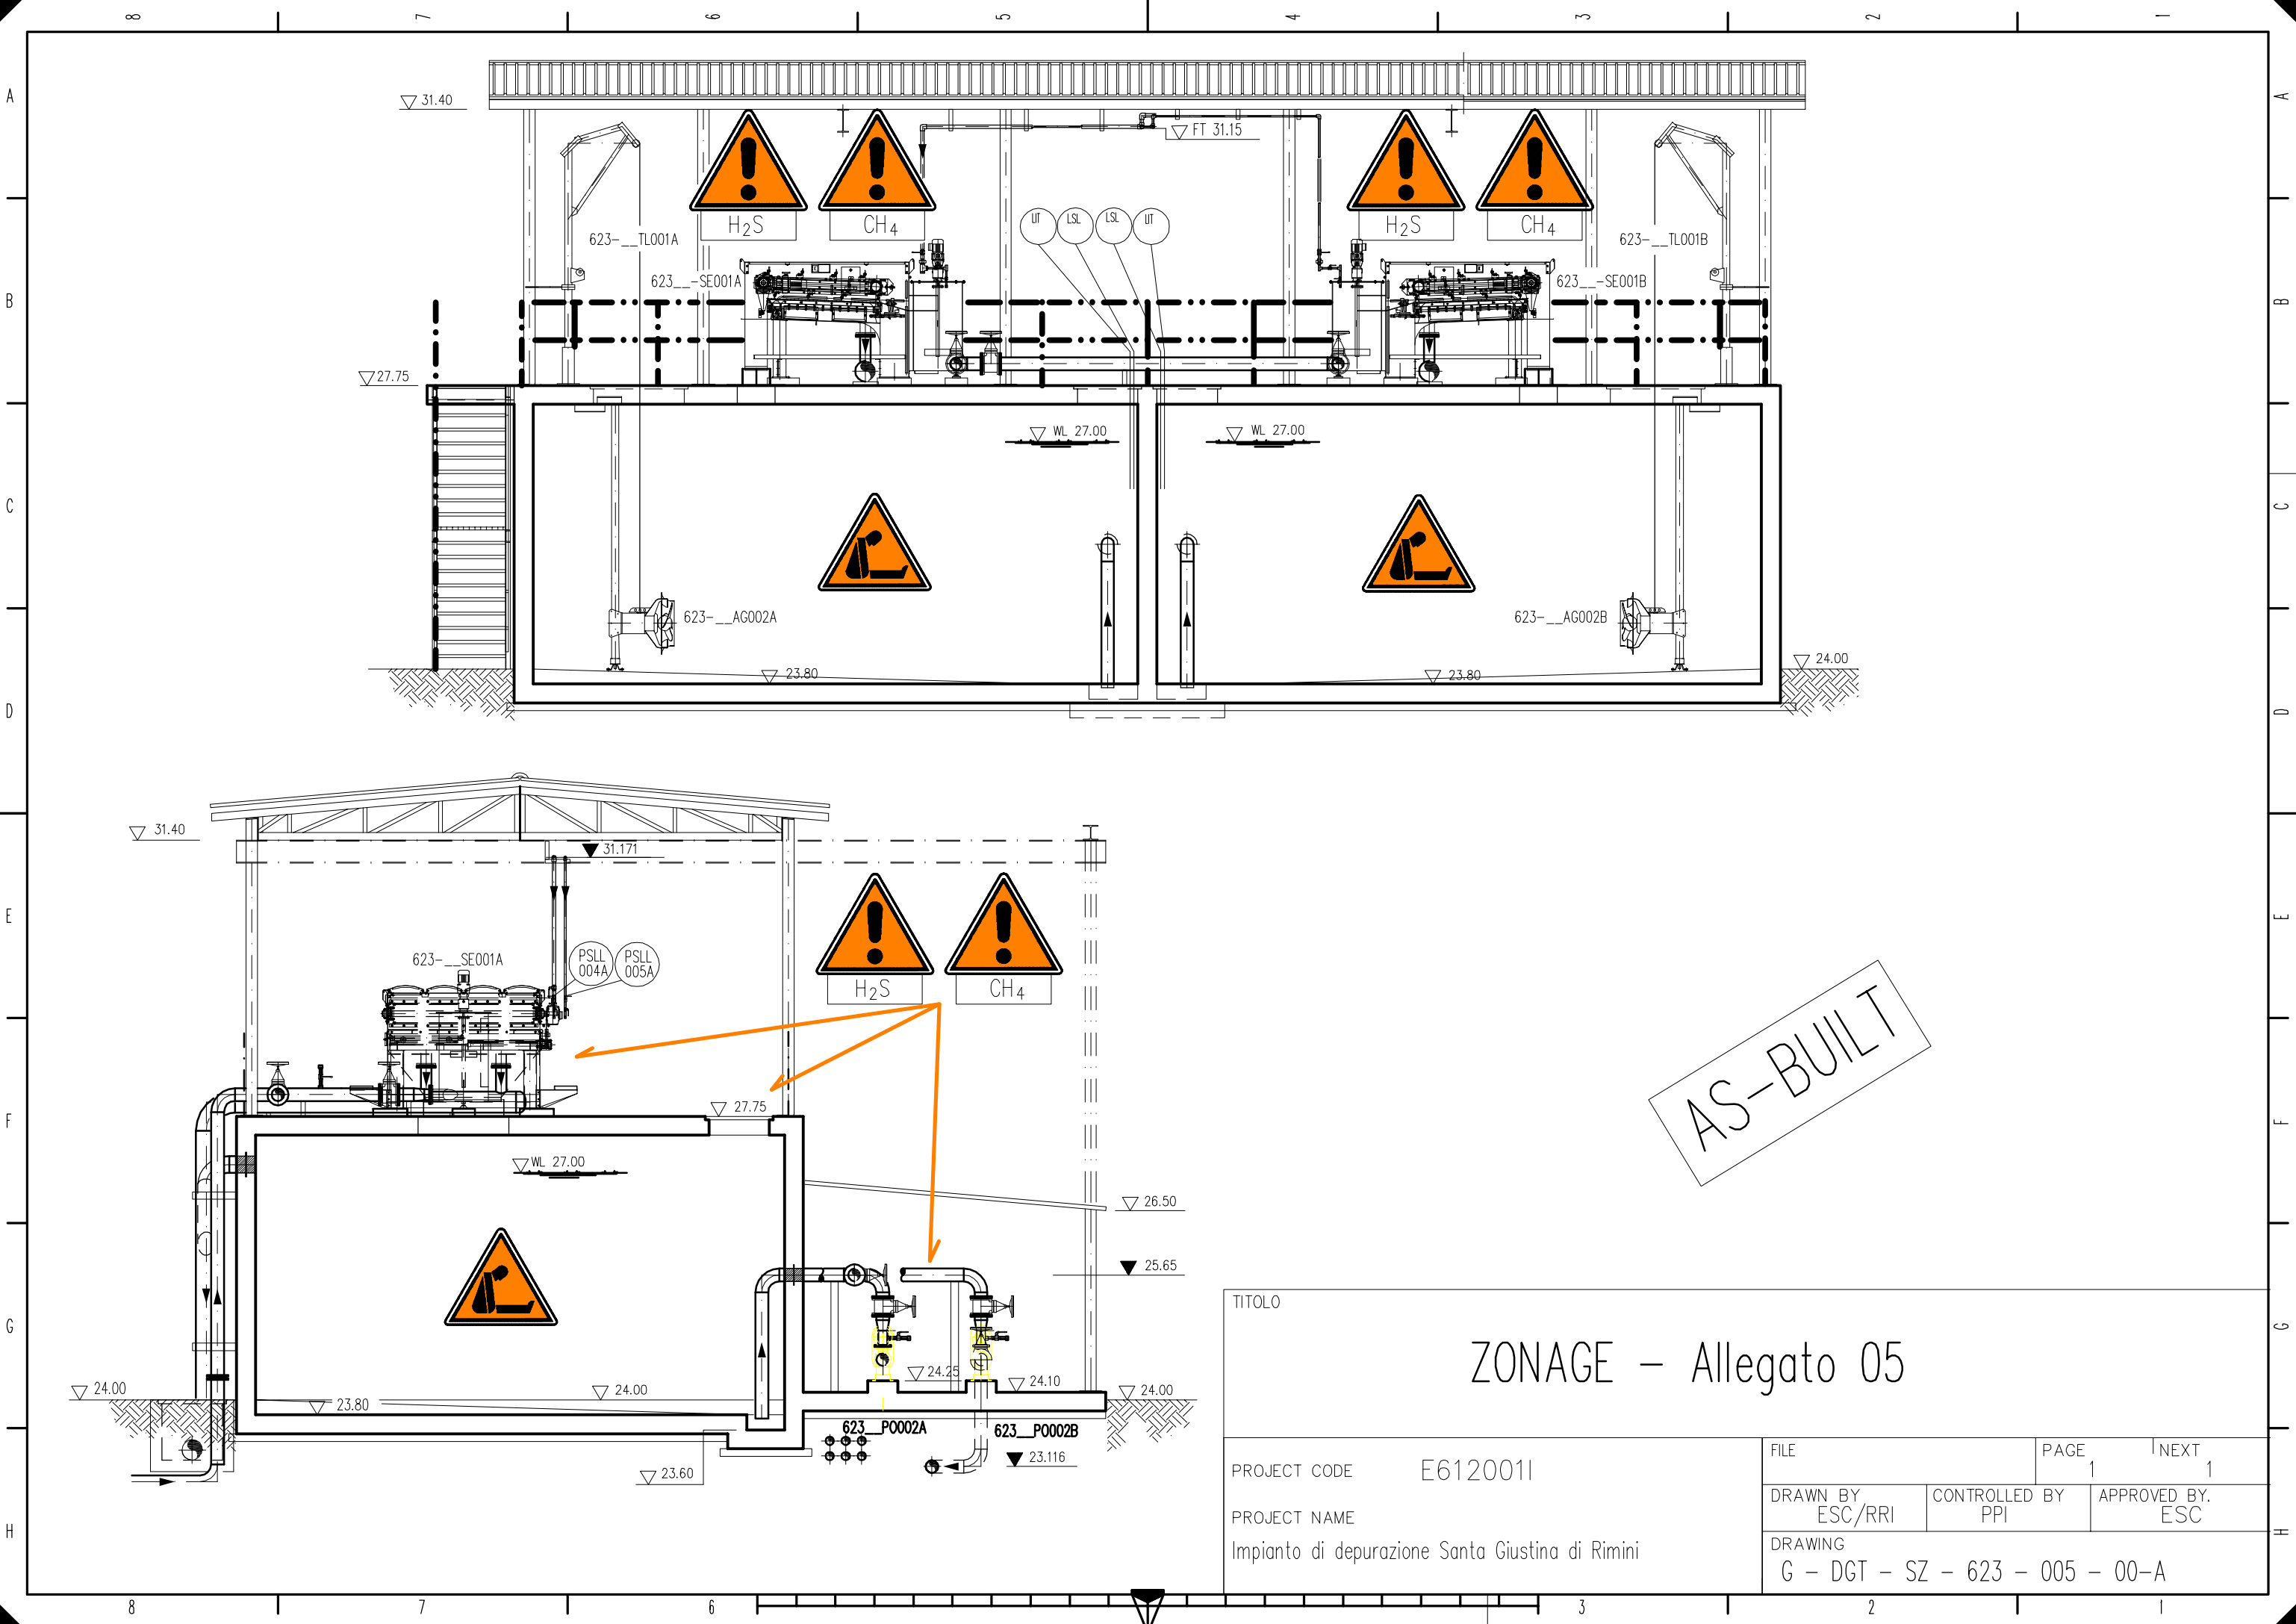


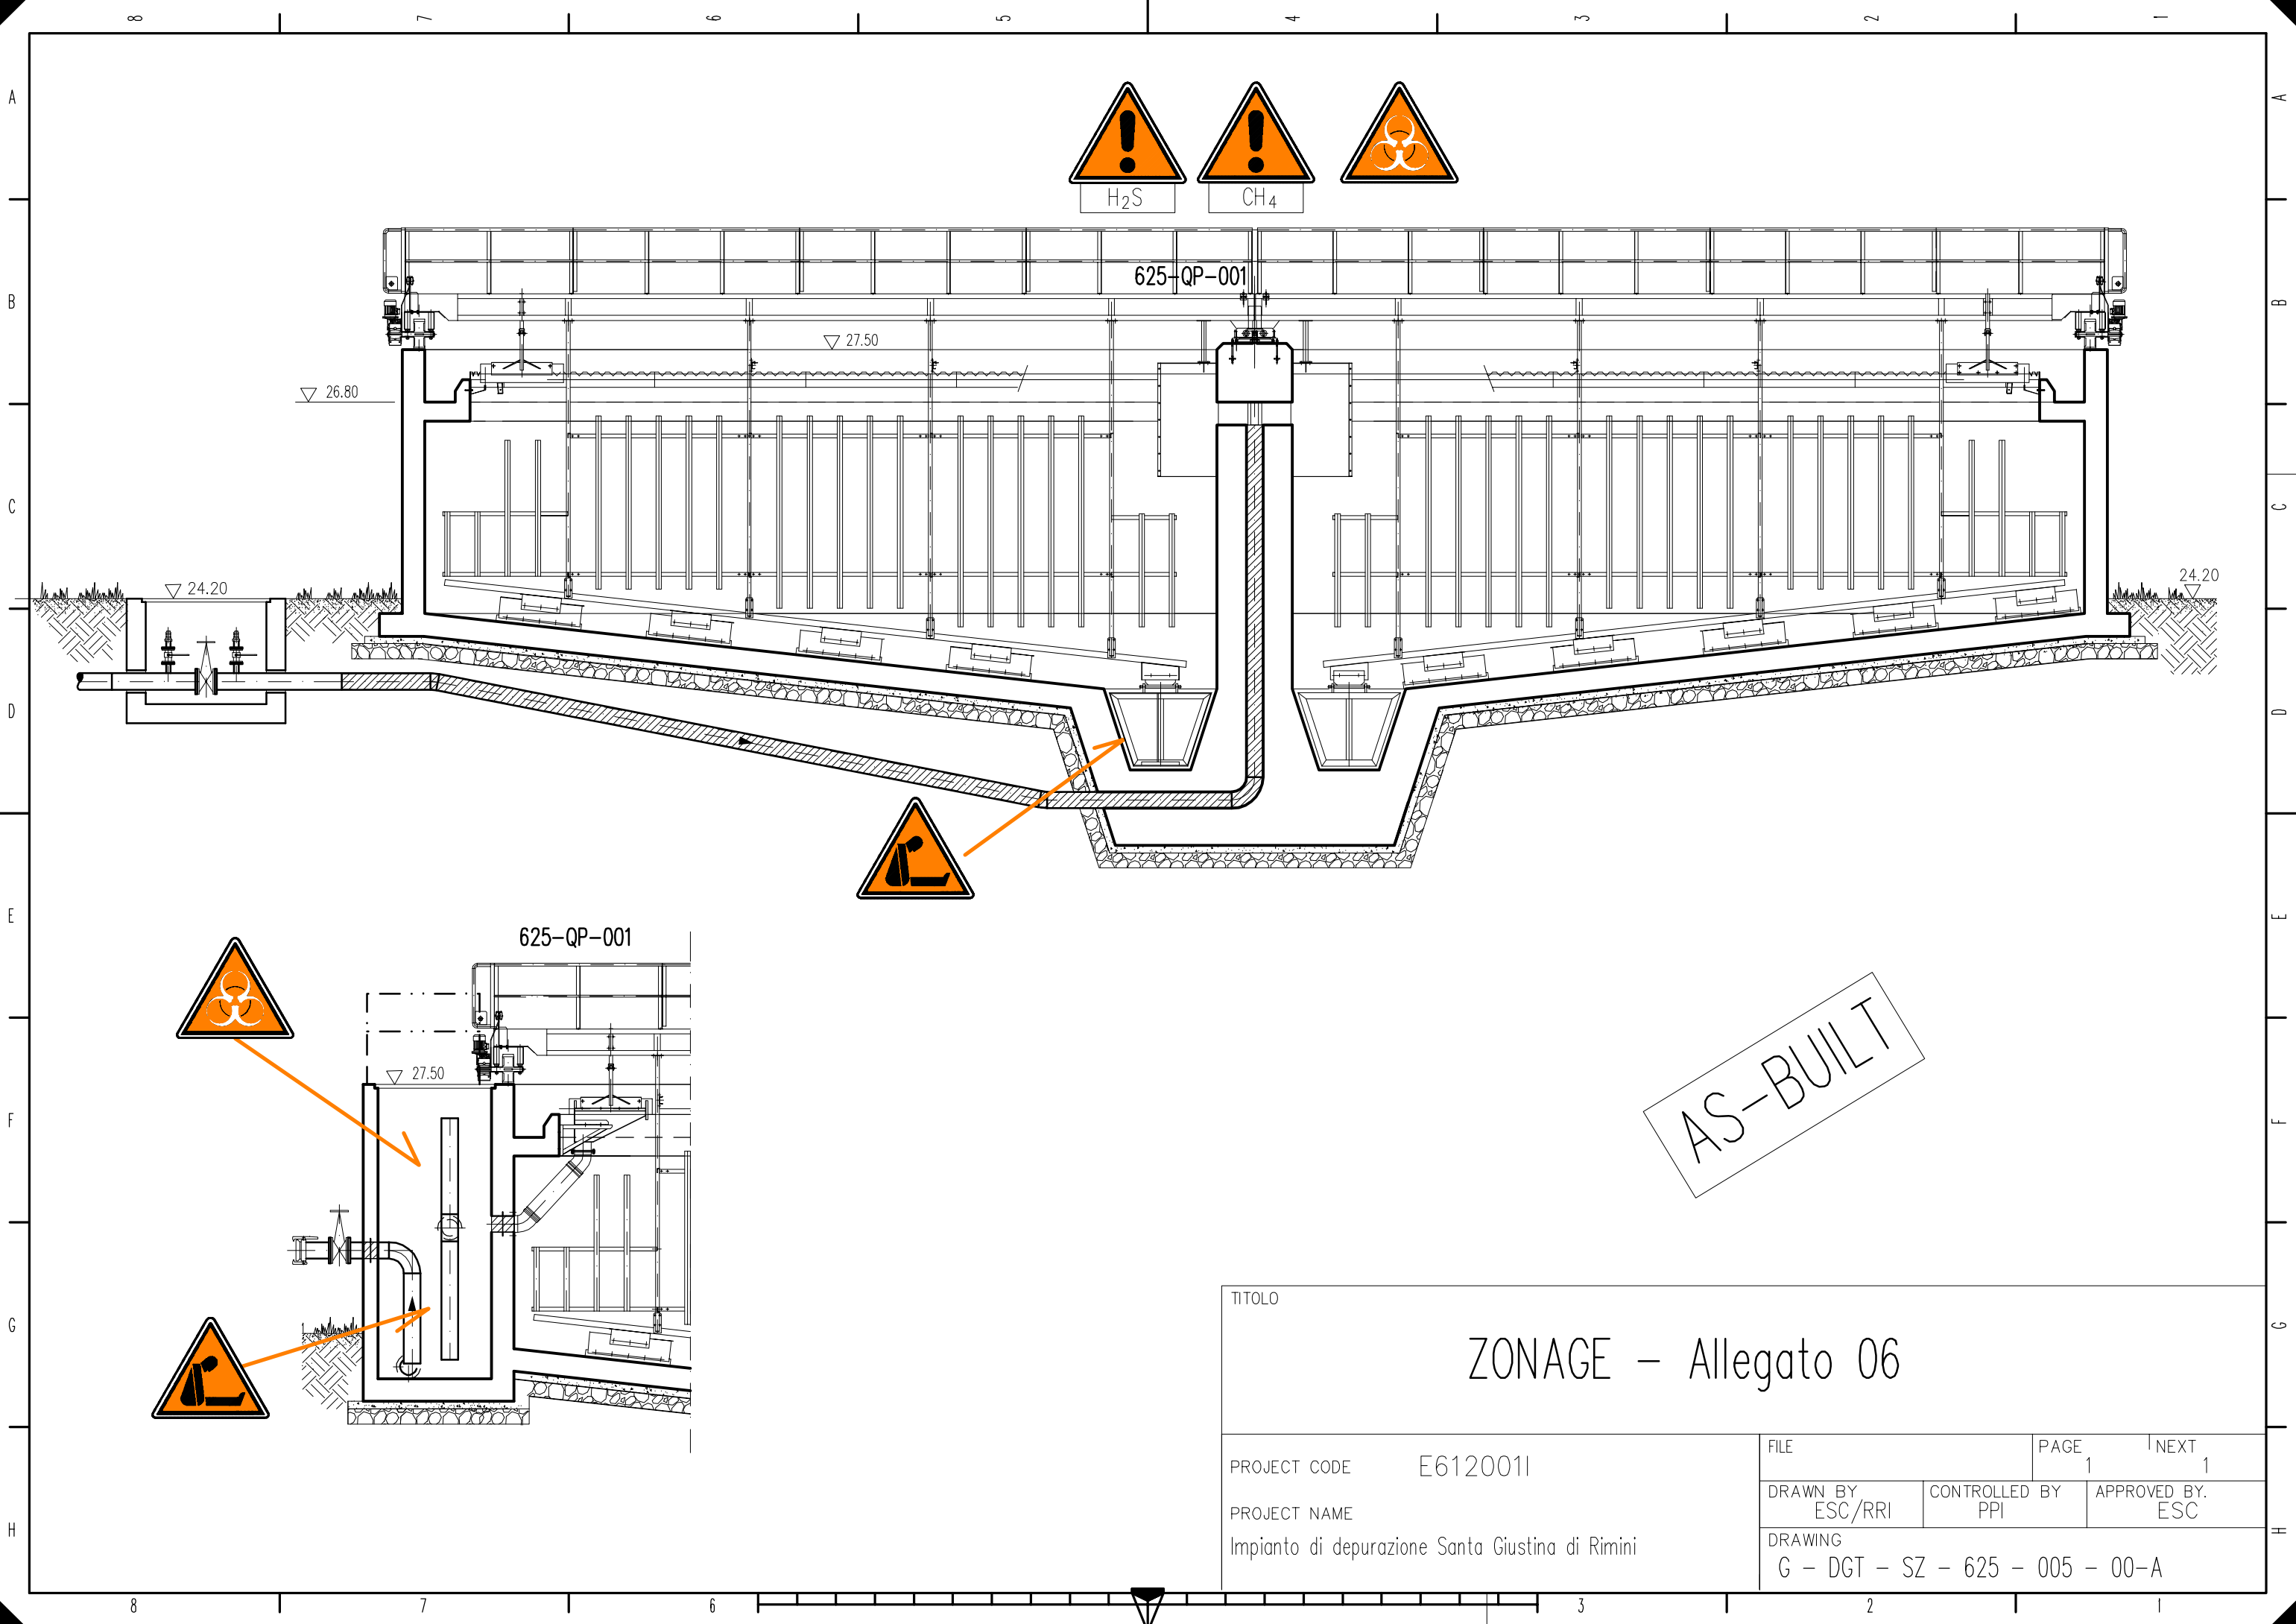

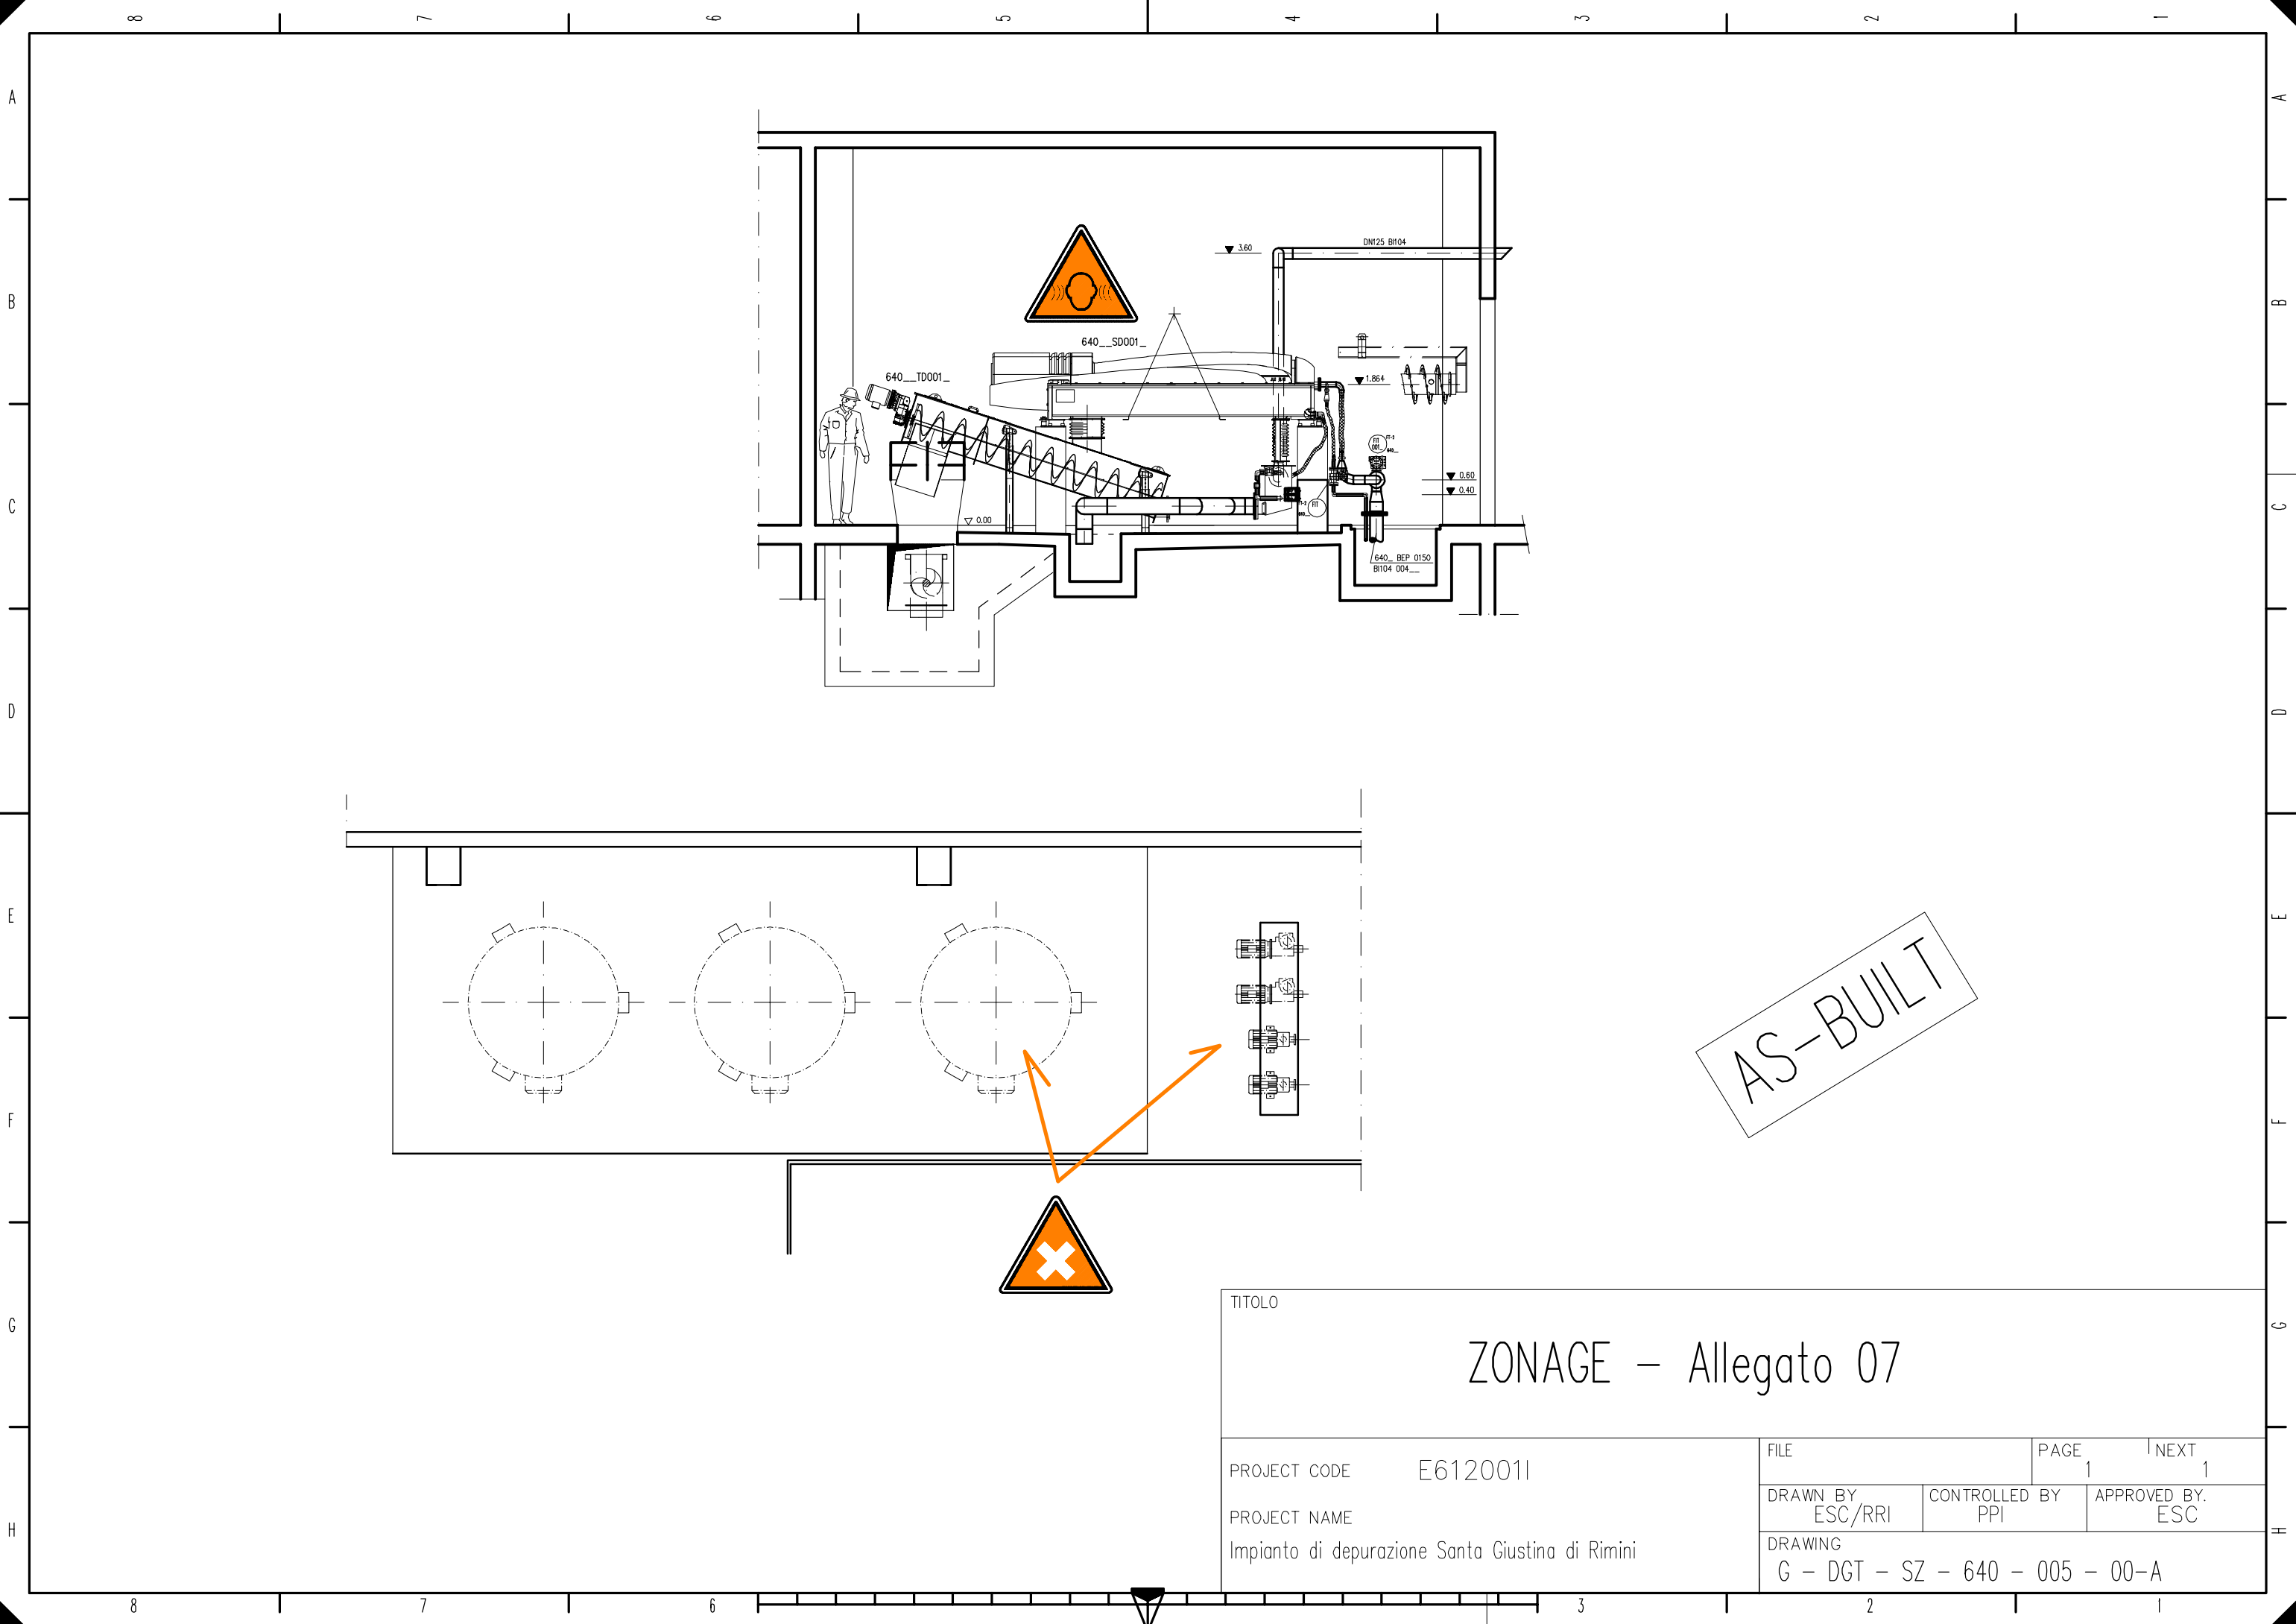


AS-BUILT



TITOLO			
ZONAGE – Allegato 07			
PROJECT CODE E612001I PROJECT NAME Impianto di depurazione Santa Giustina di Rimini	FILE		PAGE 1
	DRAWN BY ESC/RI		CONTROLLED BY PPI
	DRAWING G – DGT – SZ – 640 – 005 – 00-A		APPROVED BY. ESC

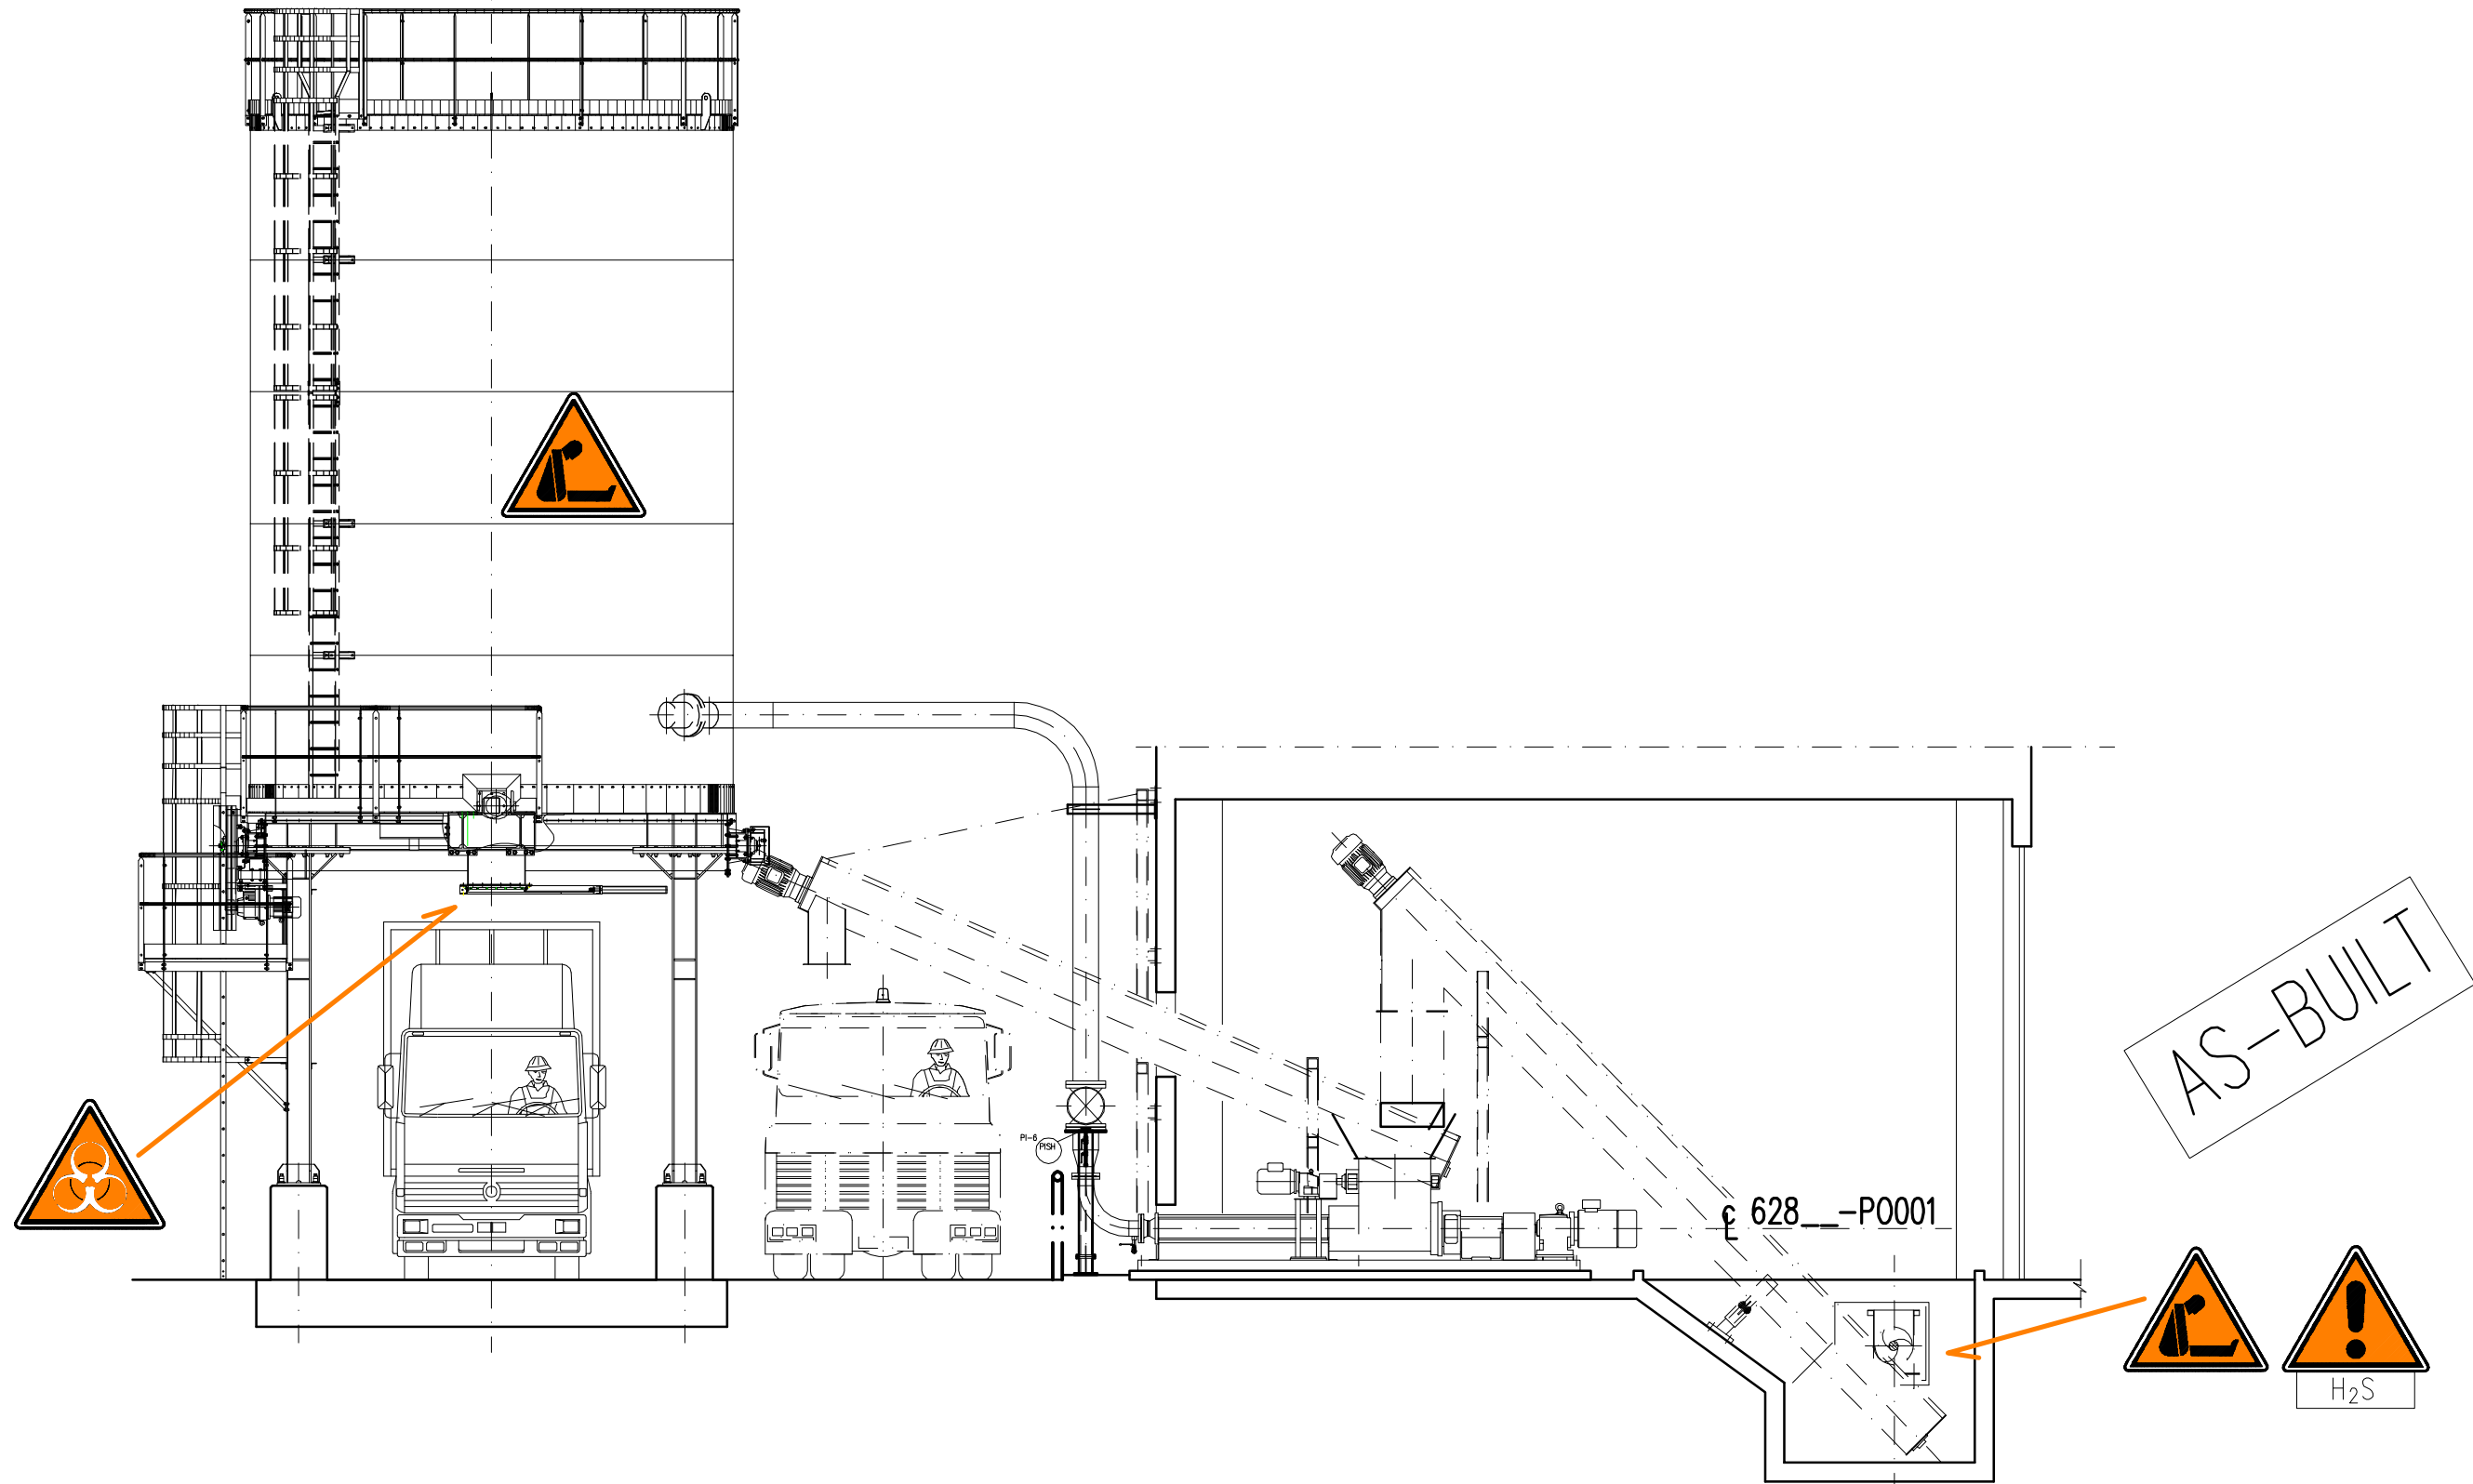

TITOLO			
ZONAGE - Allegato 08			
PROJECT CODE E612001	FILE		PAGE 1 NEXT 1
	DRAWN BY ESC/RI	CONTROLLED BY PPI	APPROVED BY. ESC
	DRAWING G - DGT - SZ - 628 - 005 - 00-A		

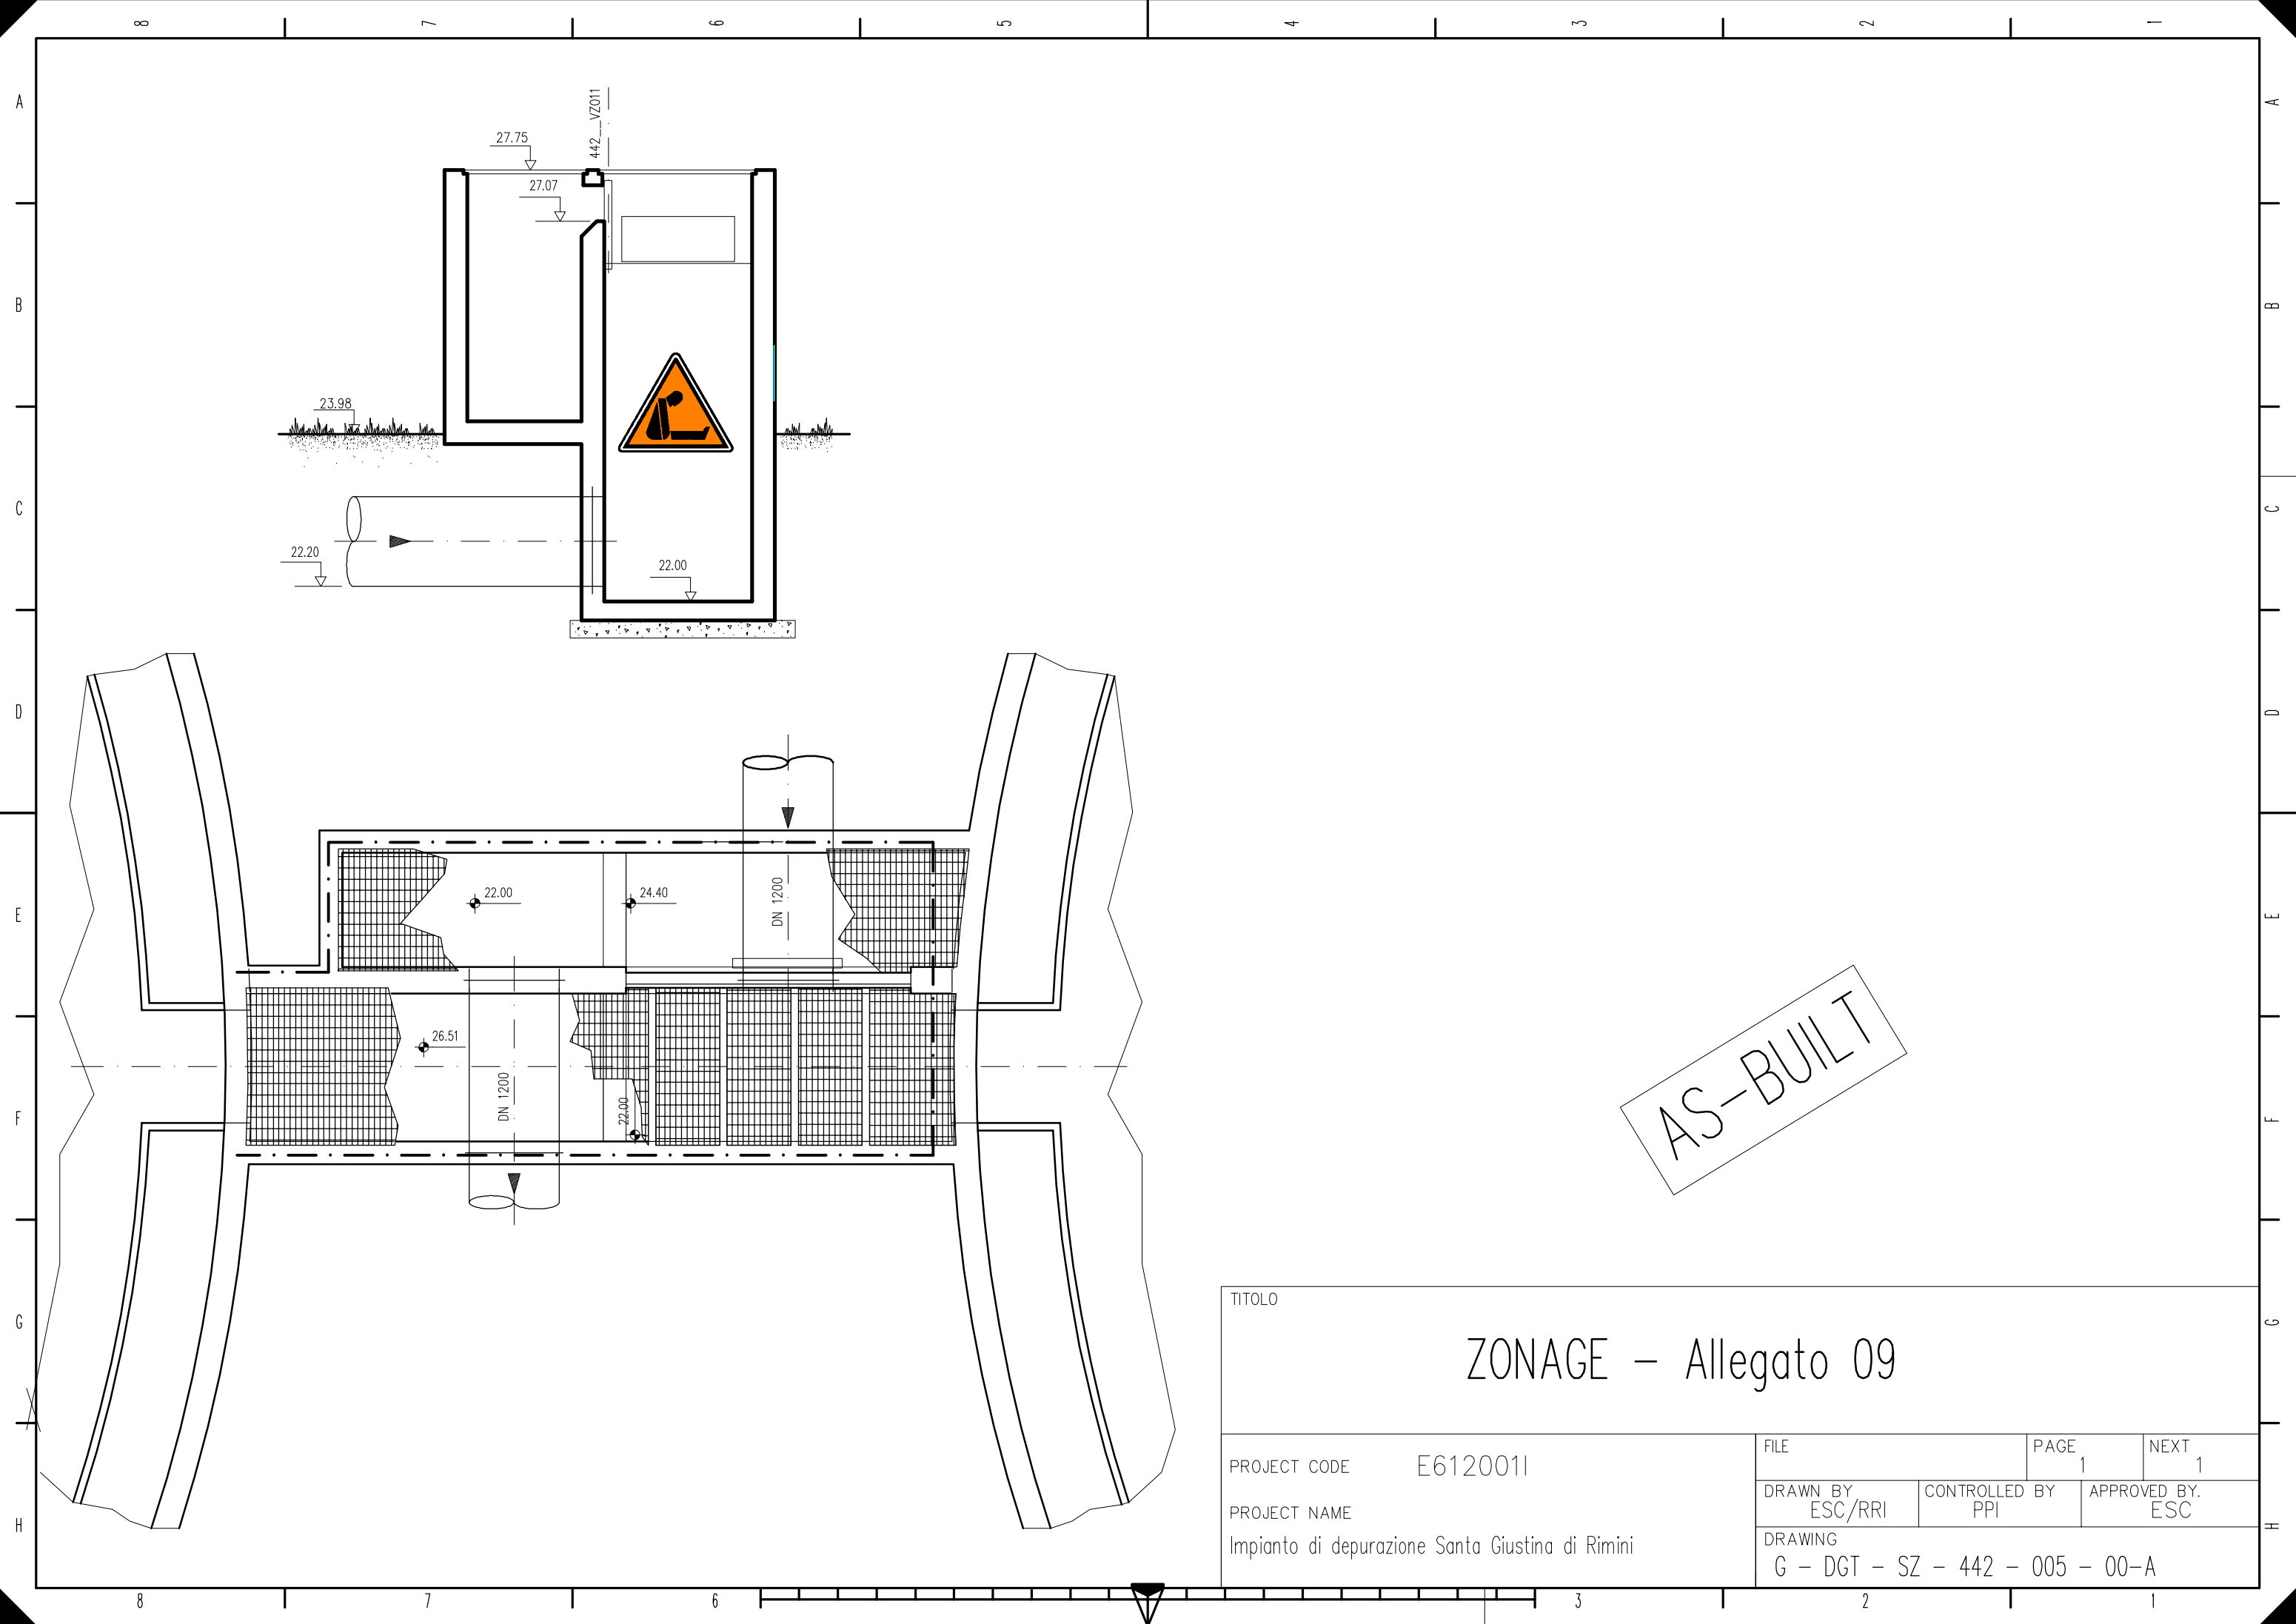

TITOLO			
ZONAGE – Allegato 09			
PROJECT CODE E612001I PROJECT NAME Impianto di depurazione Santa Giustina di Rimini	FILE		PAGE 1
	DRAWN BY ESC/RII		CONTROLLED BY PPI
	DRAWING G – DGT – SZ – 442 – 005 – 00–A		APPROVED BY. ESC

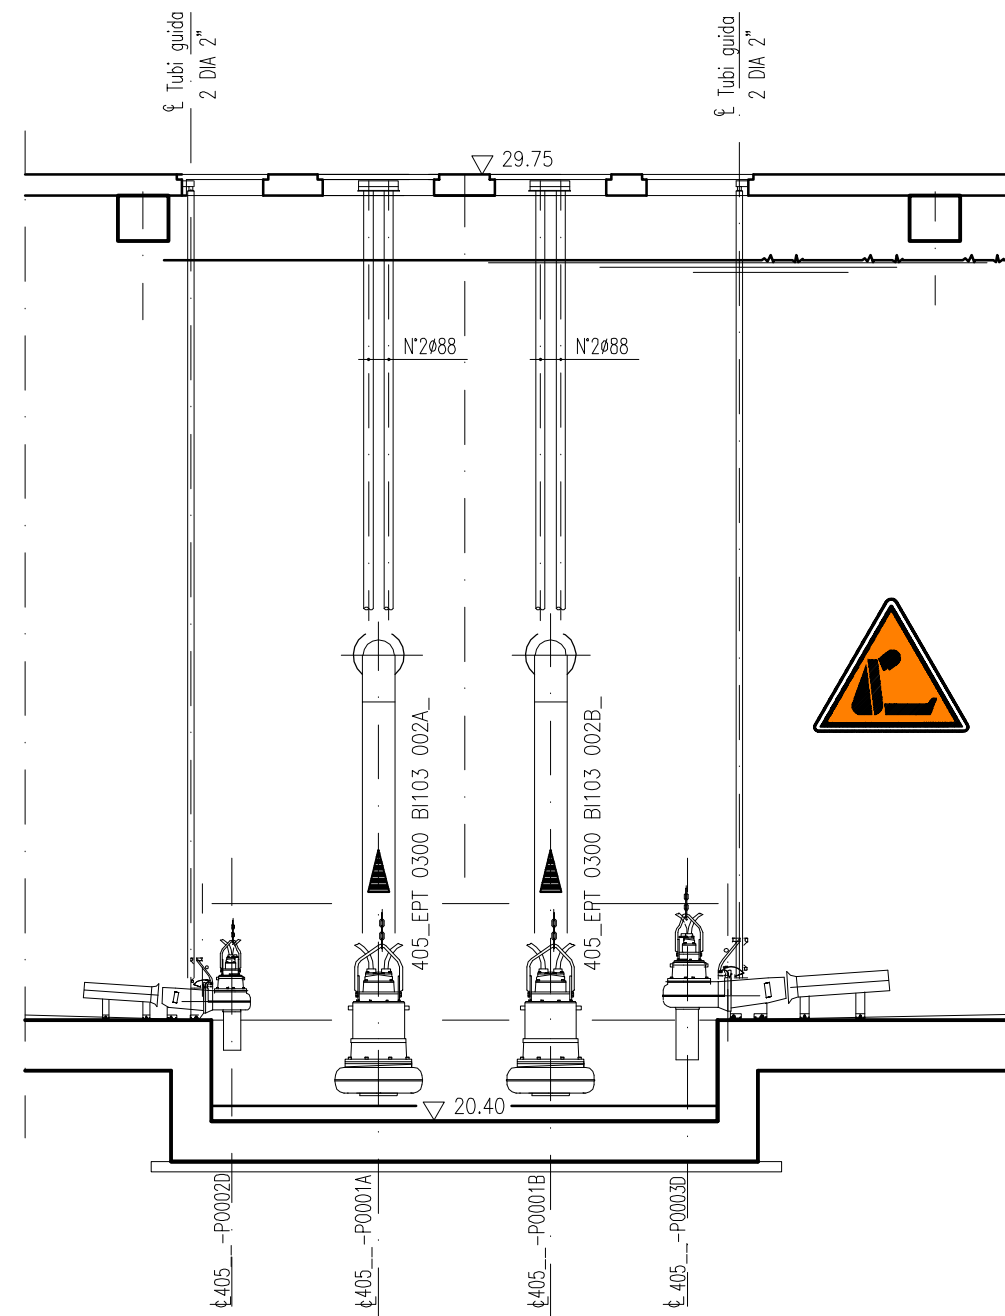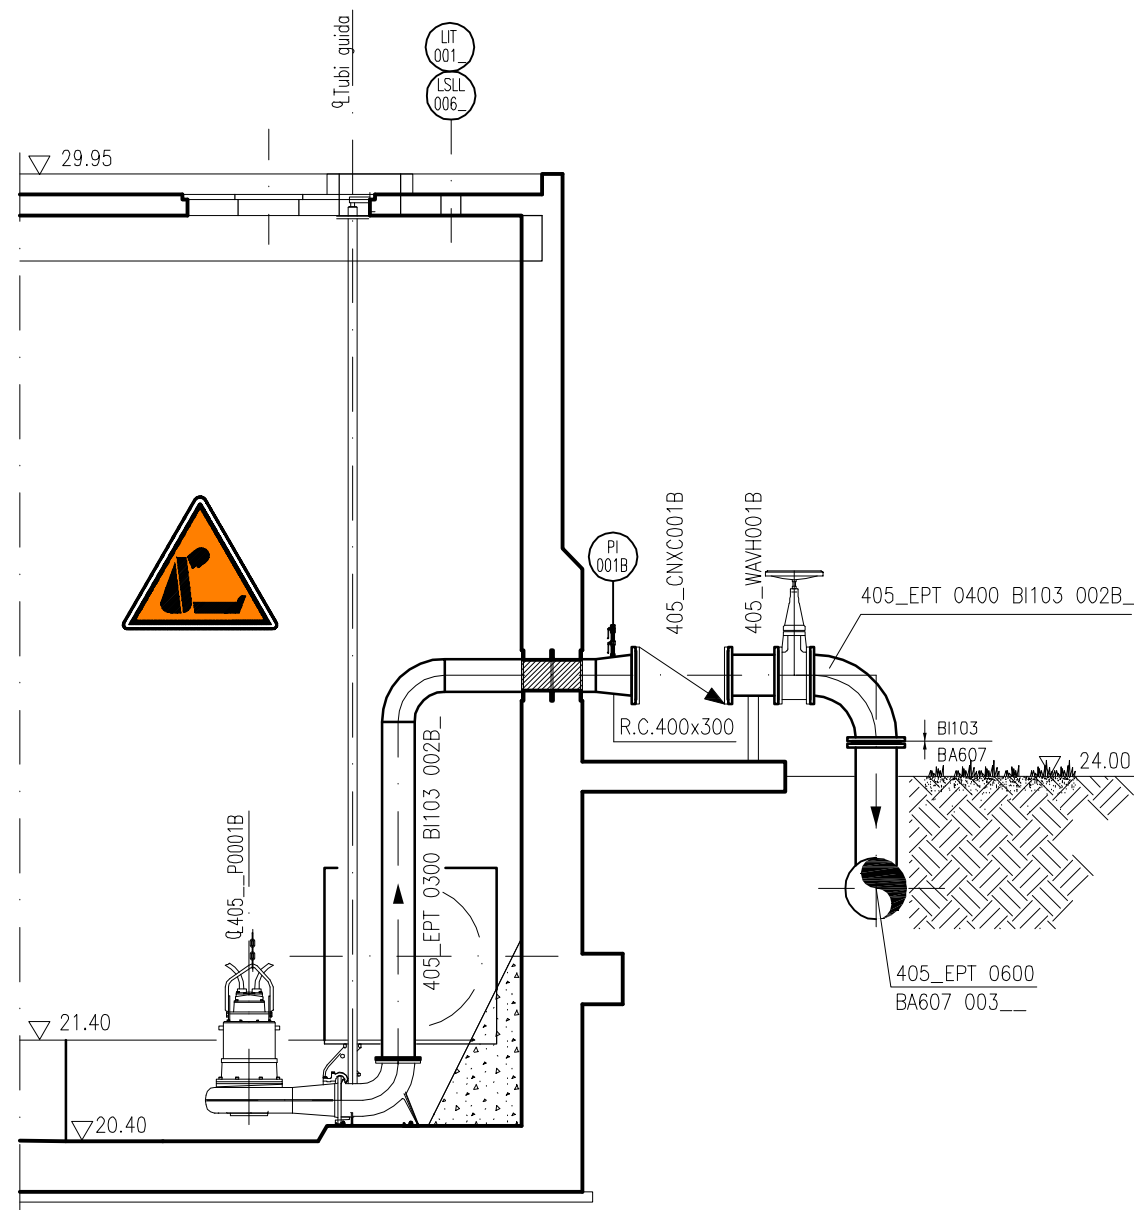

AS-BUILT

TITOLO

ZONAGE – Allegato 10

PROJECT CODE E612001I

PROJECT NAME

Impianto di depurazione Santa Giustina di Rimini

FILE

PAGE

NEXT 2




DRAWN BY
ESC/RRI

CONTROLLED BY
PPI

APPROVED BY.
ESC


DRAWING

G – DGT – SZ – 405 – 005 – 00-A

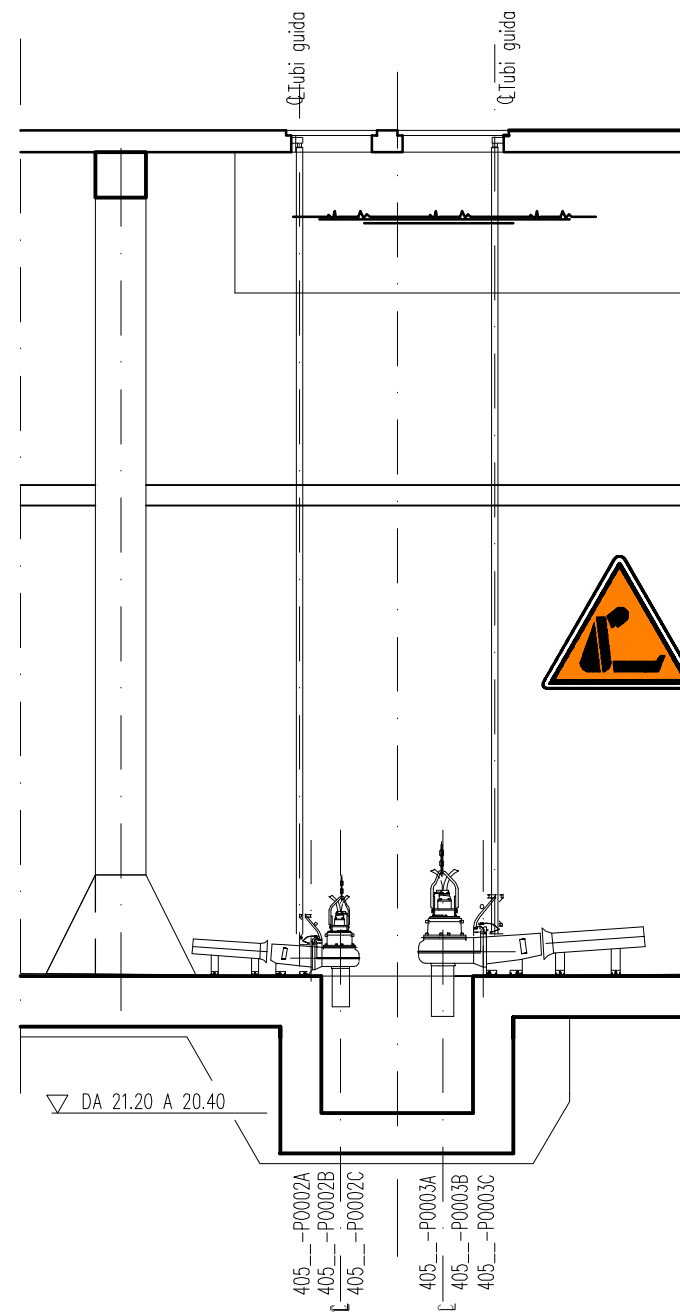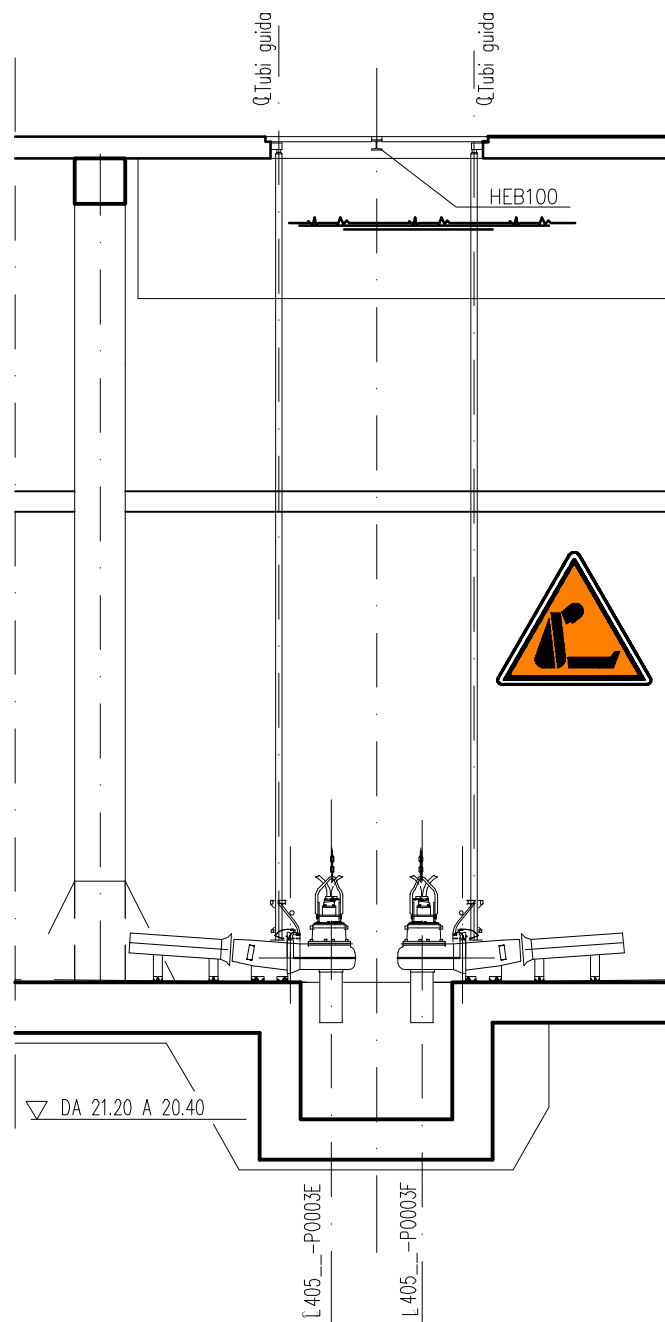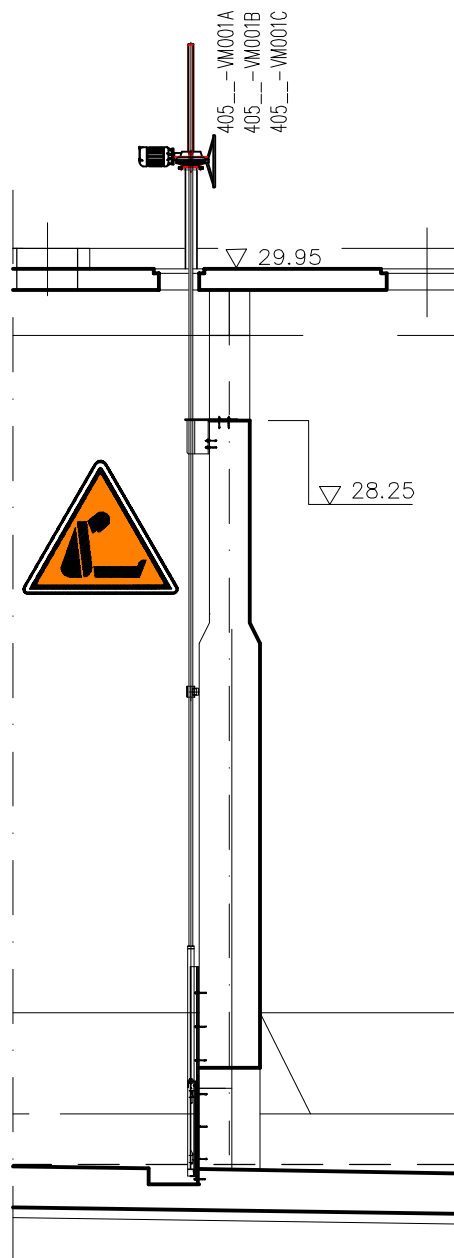


AS-BUILT

TITOLO			
ZONAGE – Allegato 10			
PROJECT CODE E612001I	FILE		PAGE 2 NEXT 2
	DRAWN BY ESC/RI	CONTROLLED BY PPI	APPROVED BY. ESC
	DRAWING G – DGT – SZ – 405 – 005 – 00-A		

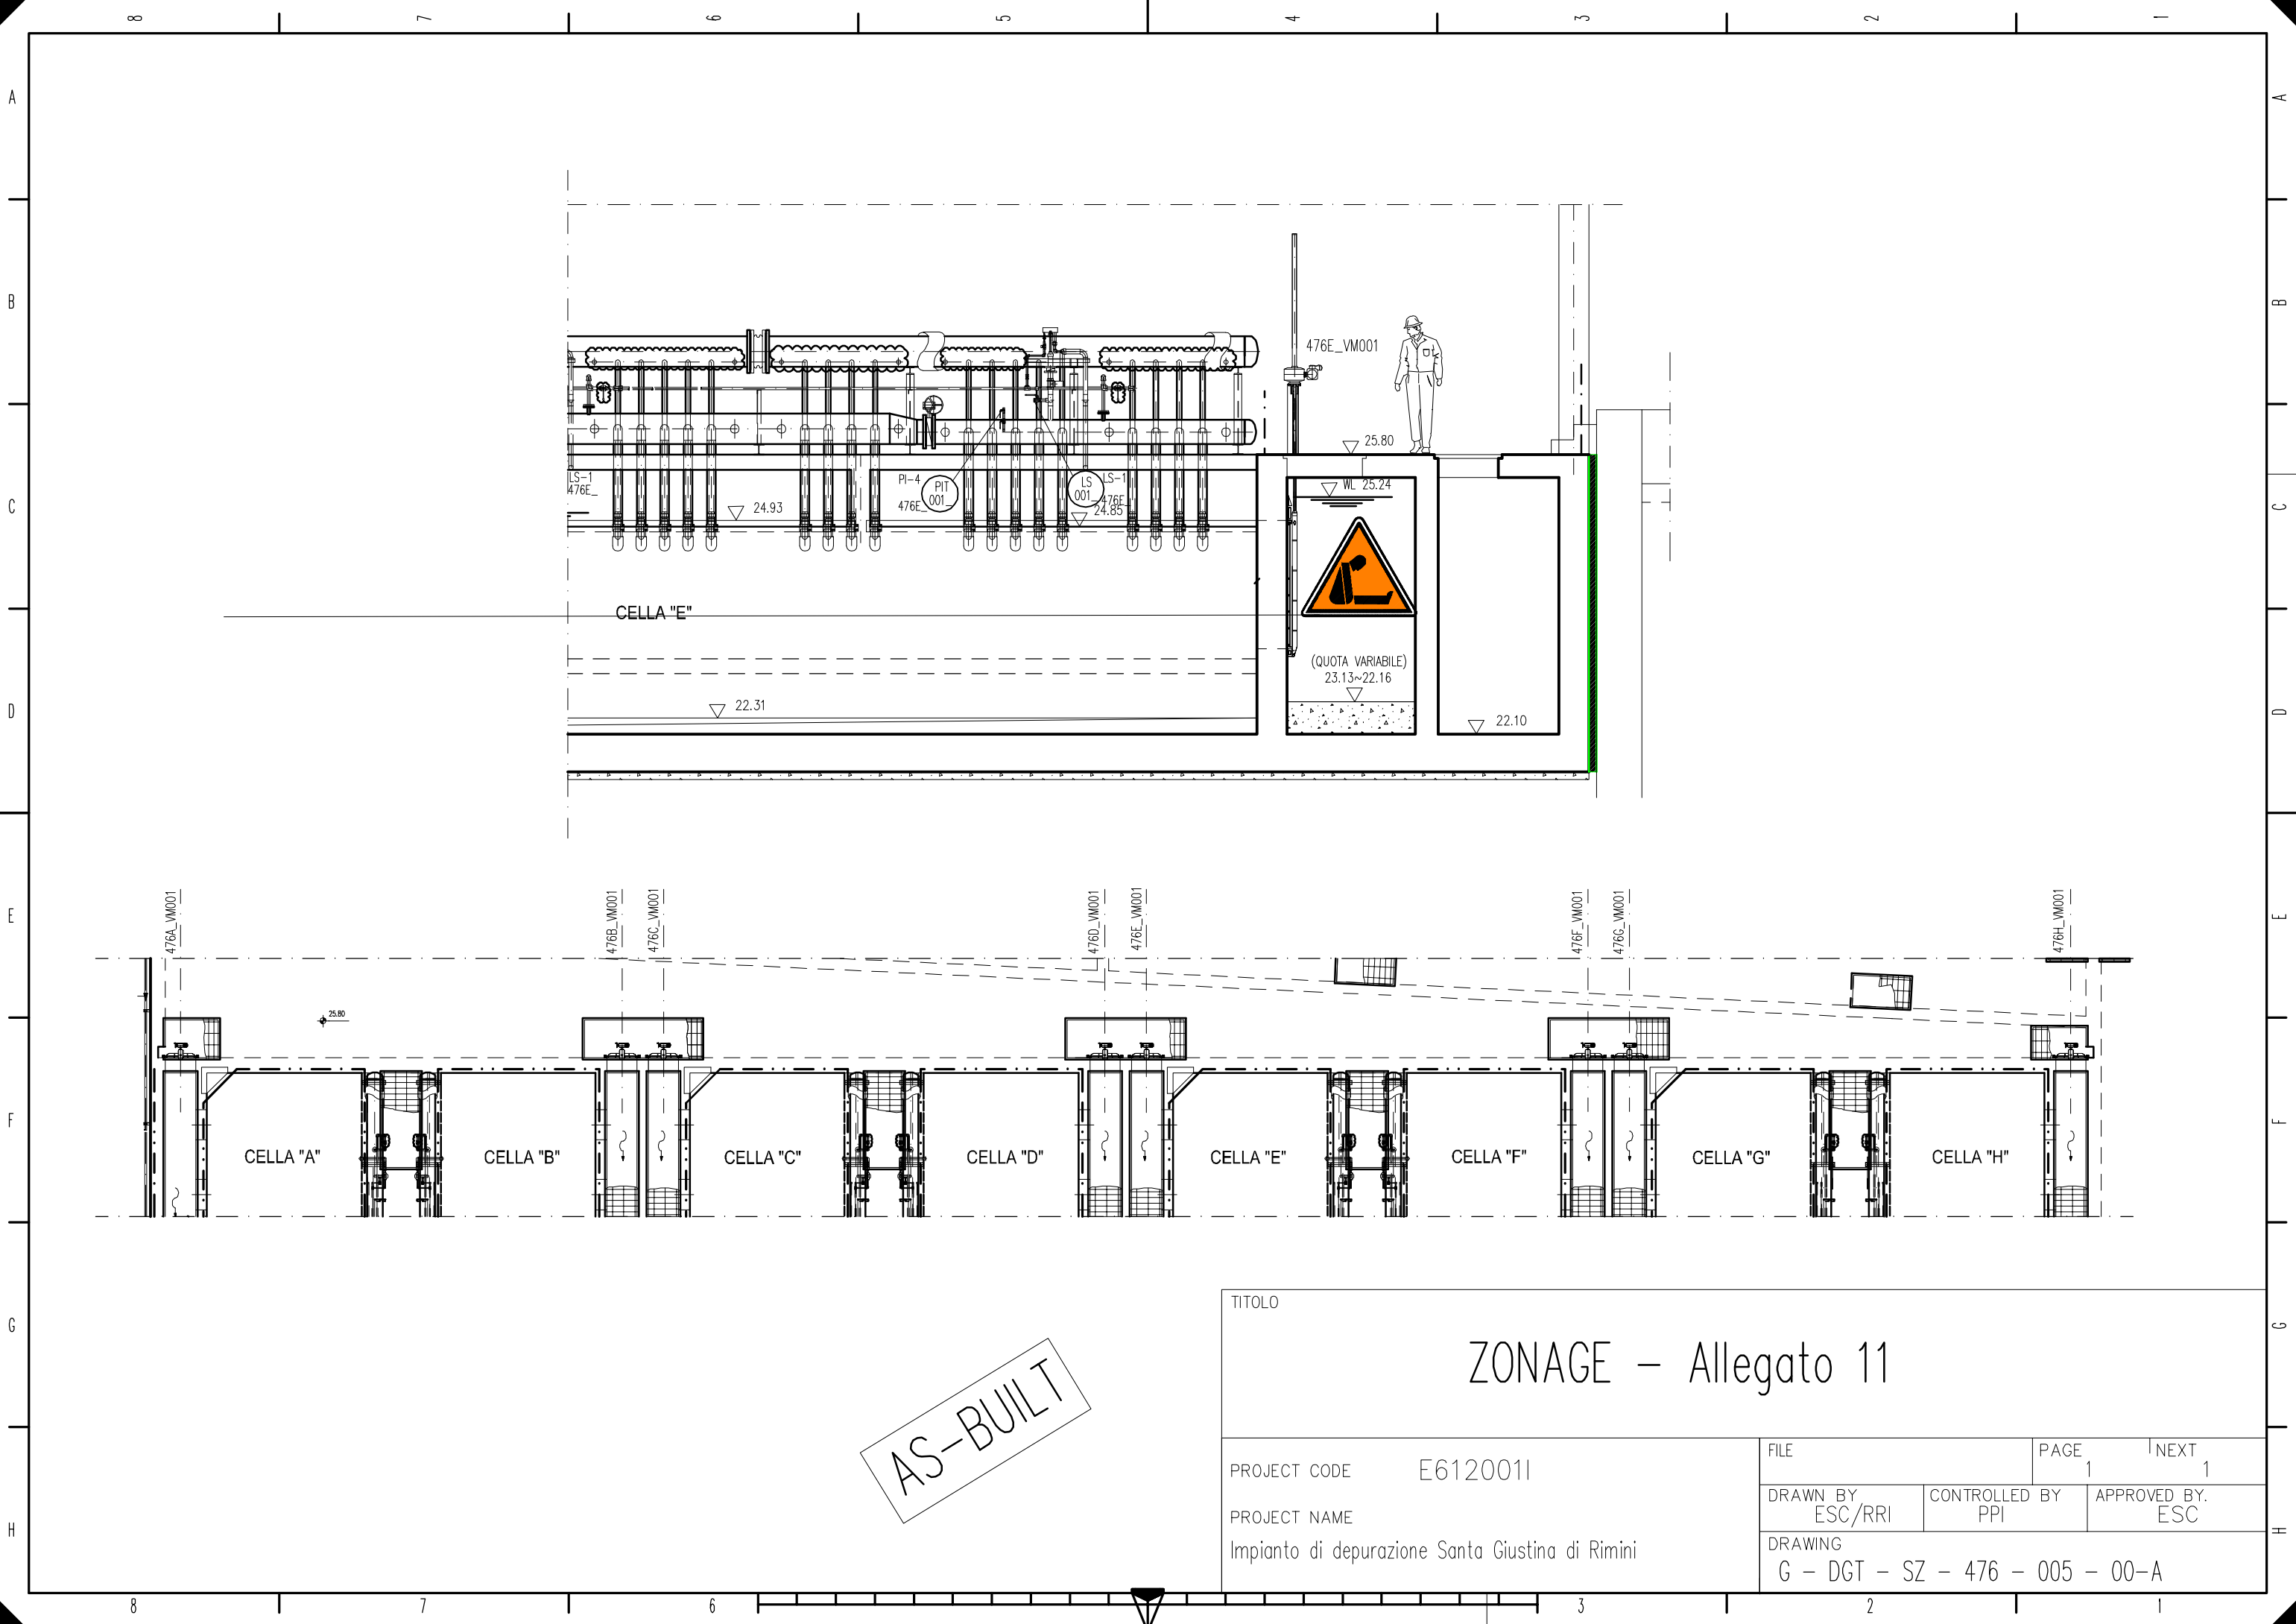

AS-BUILT

TITOLO			
ZONAGE – Allegato 11			
PROJECT CODE E6120011	FILE		PAGE 1 NEXT 1
	DRAWN BY ESC/RRI	CONTROLLED BY PPI	APPROVED BY. ESC
	DRAWING G – DGT – SZ – 476 – 005 – 00-A		

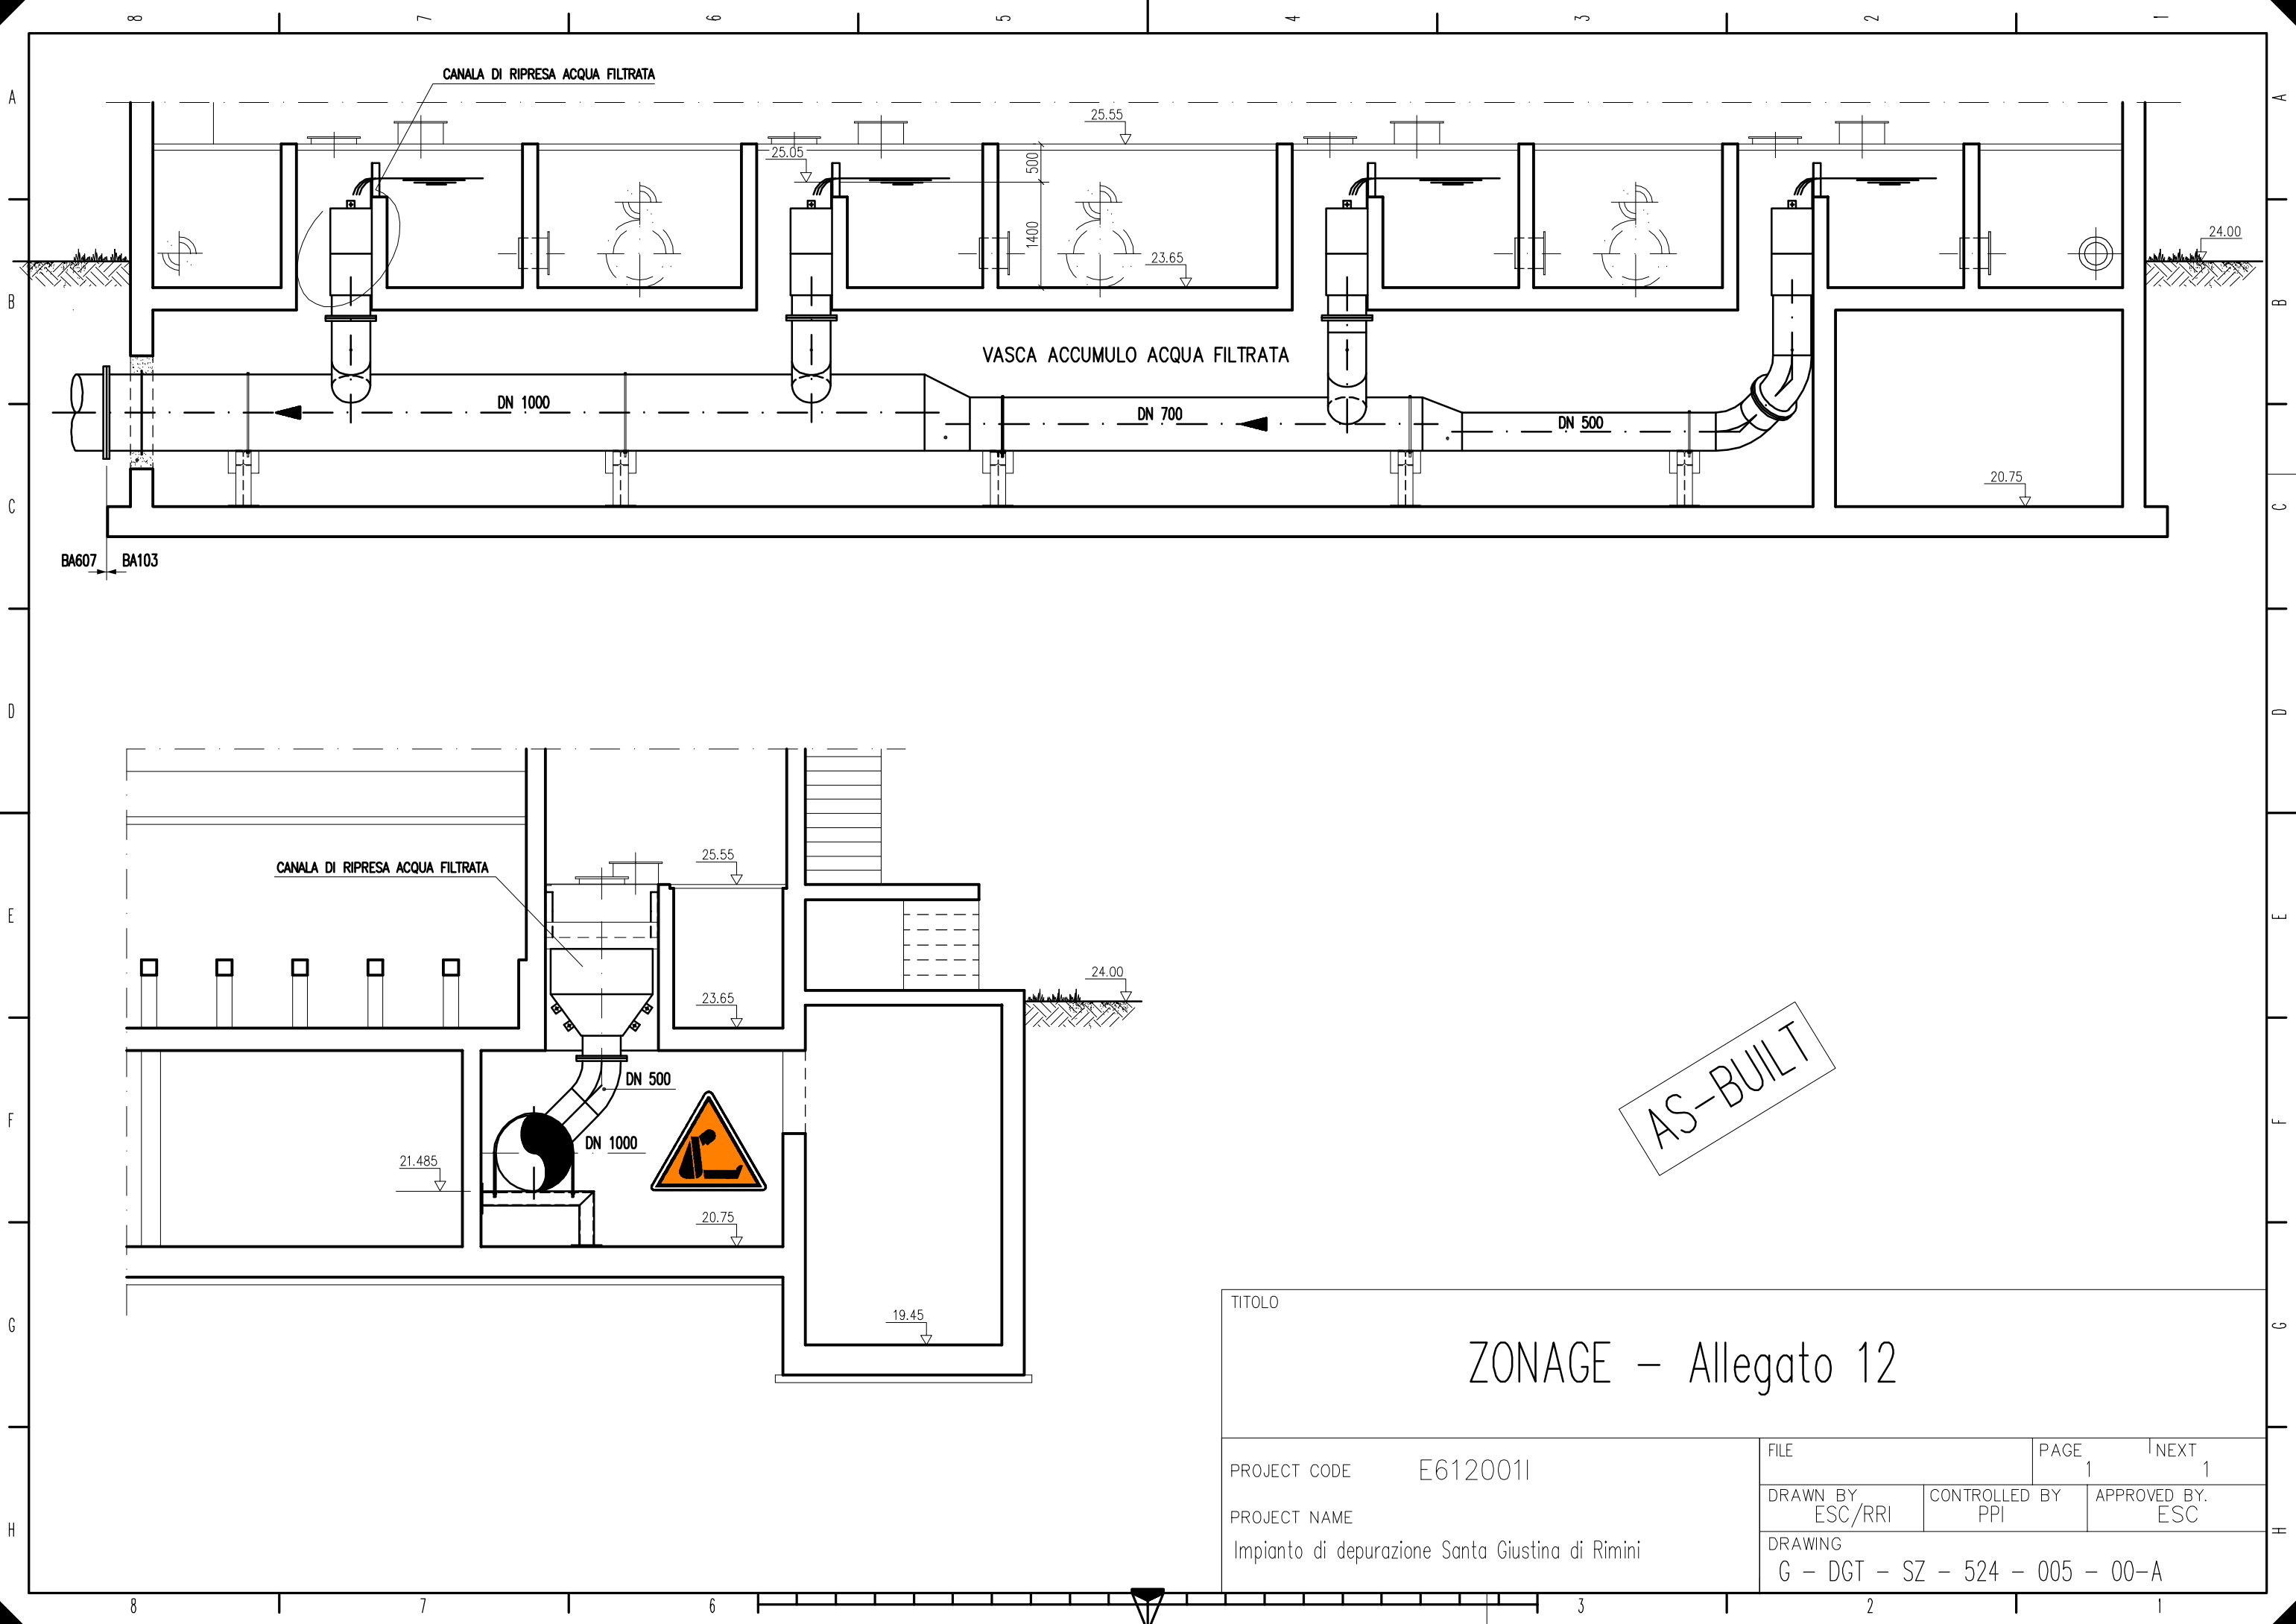

AS-BUILT

TITOLO			
ZONAGE – Allegato 12			
PROJECT CODE E612001I	FILE		PAGE 1 NEXT 1
	DRAWN BY ESC/RII	CONTROLLED BY PPI	APPROVED BY. ESC
	DRAWING G – DGT – SZ – 524 – 005 – 00–A		